

Correction

WATER WELL RECORD Form WWC-5 KSA 82a-1212 ID No.

MW# 12

LOCATION OF WATER WELL:	Fraction	Section Number	Township Number	Range Number
County: <u>Barton</u>	<u>SE 1/4 NW 1/4</u>	<u>1</u>	T <u>18</u> S <u>15</u> E <u>W</u>	

Distance and direction from nearest town or city street address of well if located within city?

2nd Jackson Omitz KS

WATER WELL OWNER: 2nd United Ag Service Inc

RA, St. Address, Box # : 2nd Jackson


State, ZIP Code : 17511

Board of Agriculture, Division of Water Resources

Application Number:

LOCATE WELL'S LOCATION WITH: 4 DEPTH OF COMPLETED WELL: 32 ft. ELEVATION:

AN "X" IN SECTION BOX:

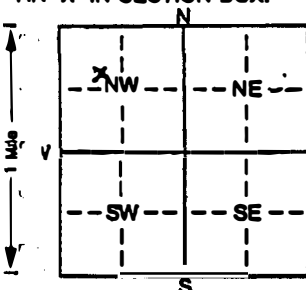

Depth(s) Groundwater Encountered 1. ft. 2. ft. 3. ft.

WELL'S STATIC WATER LEVEL ft. below land surface measured on mo/day/yr

Pump test data: Well water was ft. after hours pumping gpm

Est. Yield gpm: Well water was ft. after hours pumping gpm

Bore Hole Diameter: 5 1/4 in. to 30 in. and in. to ft.

WELL WATER TO BE USED AS: 5 Public water supply 8 Air conditioning 11 Injection well

1 Domestic 3 Feedlot 8 Oil field water supply 9 Dewatering 12 Other (Specify below)

2 Irrigation 4 Industrial 7 Domestic (lawn & garden) 10 Monitoring well

Was a chemical/bacteriological sample submitted to Department? Yes. No. If yes, mo/day/yr sample was submitted

Water Well Disinfected? Yes No

TYPE OF BLANK CASING USED:

1 Steel 3 RMP (SR) 5 Wrought Iron 8 Concrete tile CASING JOINTS: Glued. Clamped.

2 PVC 4 ABS 6 Asbestos-Cement 9 Other (specify below) Welded. Threaded. X

Blank casing diameter in. to ft. Dia. in. to ft. Dia. in. to ft.

Casing height above land surface. in., weight 5.4 lbs./ft. Wall thickness or gauge No.

TYPE OF SCREEN OR PERFORATION MATERIAL:

Steel 3 Stainless steel 5 Fiberglass 10 PVC 10 Asbestos-cement

2 Brass 4 Galvanized steel 6 Concrete tile 8 RMP (SR) 11 Other (specify)

12 None used (open hole)

SCREEN OR PERFORATION OPENINGS ARE:

Continuous slot 5 Mill slot 0.10 5 Gauzed wrapped 8 Saw cut 11 None (open hole)

2 Louvered shutter 4 Key punched 6 Wire wrapped 9 Drilled holes 12 Other (specify)

SCREEN-PERFORATED INTERVALS: From. ft. to ft. From. ft. to ft.

GRAVEL PACK INTERVALS: From. ft. to ft. From. ft. to ft.

From. ft. to ft. From. ft. to ft.

From. ft. to ft. From. ft. to ft.

GROUT MATERIAL: 1 Neat cement 2 Cement grout 3 Bentonite 4 Other

Grout intervals: From. ft. to ft. From. ft. to ft. From. ft. to ft.

What is the nearest source of possible contamination:

1 Septic tank 4 Lateral lines 7 Pit privy 10 Livestock pens 14 Abandoned water well

2 Sewer lines 5 Cess pool 8 Sewage lagoon 11 Fuel storage 15 Oil well/Gas well

3 Watertight sewer lines 6 Seepage pit 9 Feedyard 12 Fertilizer storage 16 Other (specify below)

Direction from well? South How many feet? 10

FROM TO LITHOLOGIC LOG FROM TO PLUGGING INTERVALS

1 11 Tan Silty Clay

11 15 Tan Silty Clay w/ Limestone Fragments

15 17 Light Gray Flinted

17 26 Weathered Limestone w/ Silty Tan Clay

26 30 Weathered Limestone tan dirt

CONTRACTOR'S OR LANDOWNER'S CERTIFICATION: This water well was (1) constructed, (2) reconstructed, or (3) plugged under my jurisdiction and was completed on (mo/day/year) 10-25-99 and this record is true to the best of my knowledge and belief. Kansas

Well Contractor's Licence No. 575 This Water Well Record was completed on (mo/day/yr) 11-6-00

the business name of FIVEE AGILITY SERVICE INC by (signature) [Signature]


Distance and direction from nearest town or city street address of well if located within city?		
2nd & Jackson 01mitz KS		
2 WATER WELL OWNER :		
2nd United Ag SERVICE INC		
RR#, St. Address, Box # :	2nd & Jackson	Board of Agriculture, Division of Water Resources Application Number:
City, State, ZIP Code :	01mitz KS 67564	

5 TYPE OF BLANK CASING USED:		3 Wrought iron	8 Concrete tile	CASING JOINTS: Glued. Clamped.	
1 Steel	3 RMP (SR)	6 Asbestos-Cement	9 Other (specify below)	Welded	
② PVC	4 ABS	7 Fiberglass		Threaded. ☒	
Blank casing diameter 2 . . . in. to . . . 10 . . . ft., Dia in. to ft., Dia in. to ft.					
Casing height above land surface 0 . . . in., weight SCHED 40 . . . lbs./ft. Wall thickness or gauge No.					
TYPE OF SCREEN OR PERFORATION MATERIAL:		① PVC		10 Asbestos-cement	
1 Steel	3 Stainless steel	5 Fiberglass	8 RMP (SR)	11 Other (specify)	
2 Brass	4 Galvanized steel	6 Concrete tile	9 ABS	12 None used (open hole)	
SCREEN OR PERFORATION OPENINGS ARE:		5 Gauzed wrapped	8 Saw cut	11 None (open hole)	
1 Continuous slot	③ Mill slot 0.10	6 Wire wrapped	9 Drilled holes		
2 Louvered shutter	4 Key punched	7 Torch cut	10 Other (specify)	ft.	
SCREEN-PERFORATED INTERVALS:		From . . . 30 . . . ft. to . . . 10 . . . ft., From ft. to ft., From ft. to ft.			
GRAVEL PACK INTERVALS:		From . . . 30 . . . ft. to . . . 8 . . . ft., From ft. to ft., From ft. to ft.			
		From ft. to ft., From ft. to ft.			

[illegible]

7 CONTRACTOR'S OR LANDOWNER'S CERTIFICATION: This water well was ~~new~~ constructed, (2) reconstructed, or (3) plugged under my jurisdiction and was completed on (mo/day/year) 10-23-00 and this record is true to the best of my knowledge and belief. Kansas Water Well Contractor's Licence No. 575 This Water Well Record was completed on (mo/day/yr) 11-6-00 under the business name of FUNKEE DRILLING SERVICE, INC. by (signature) [Signature]

Barton County

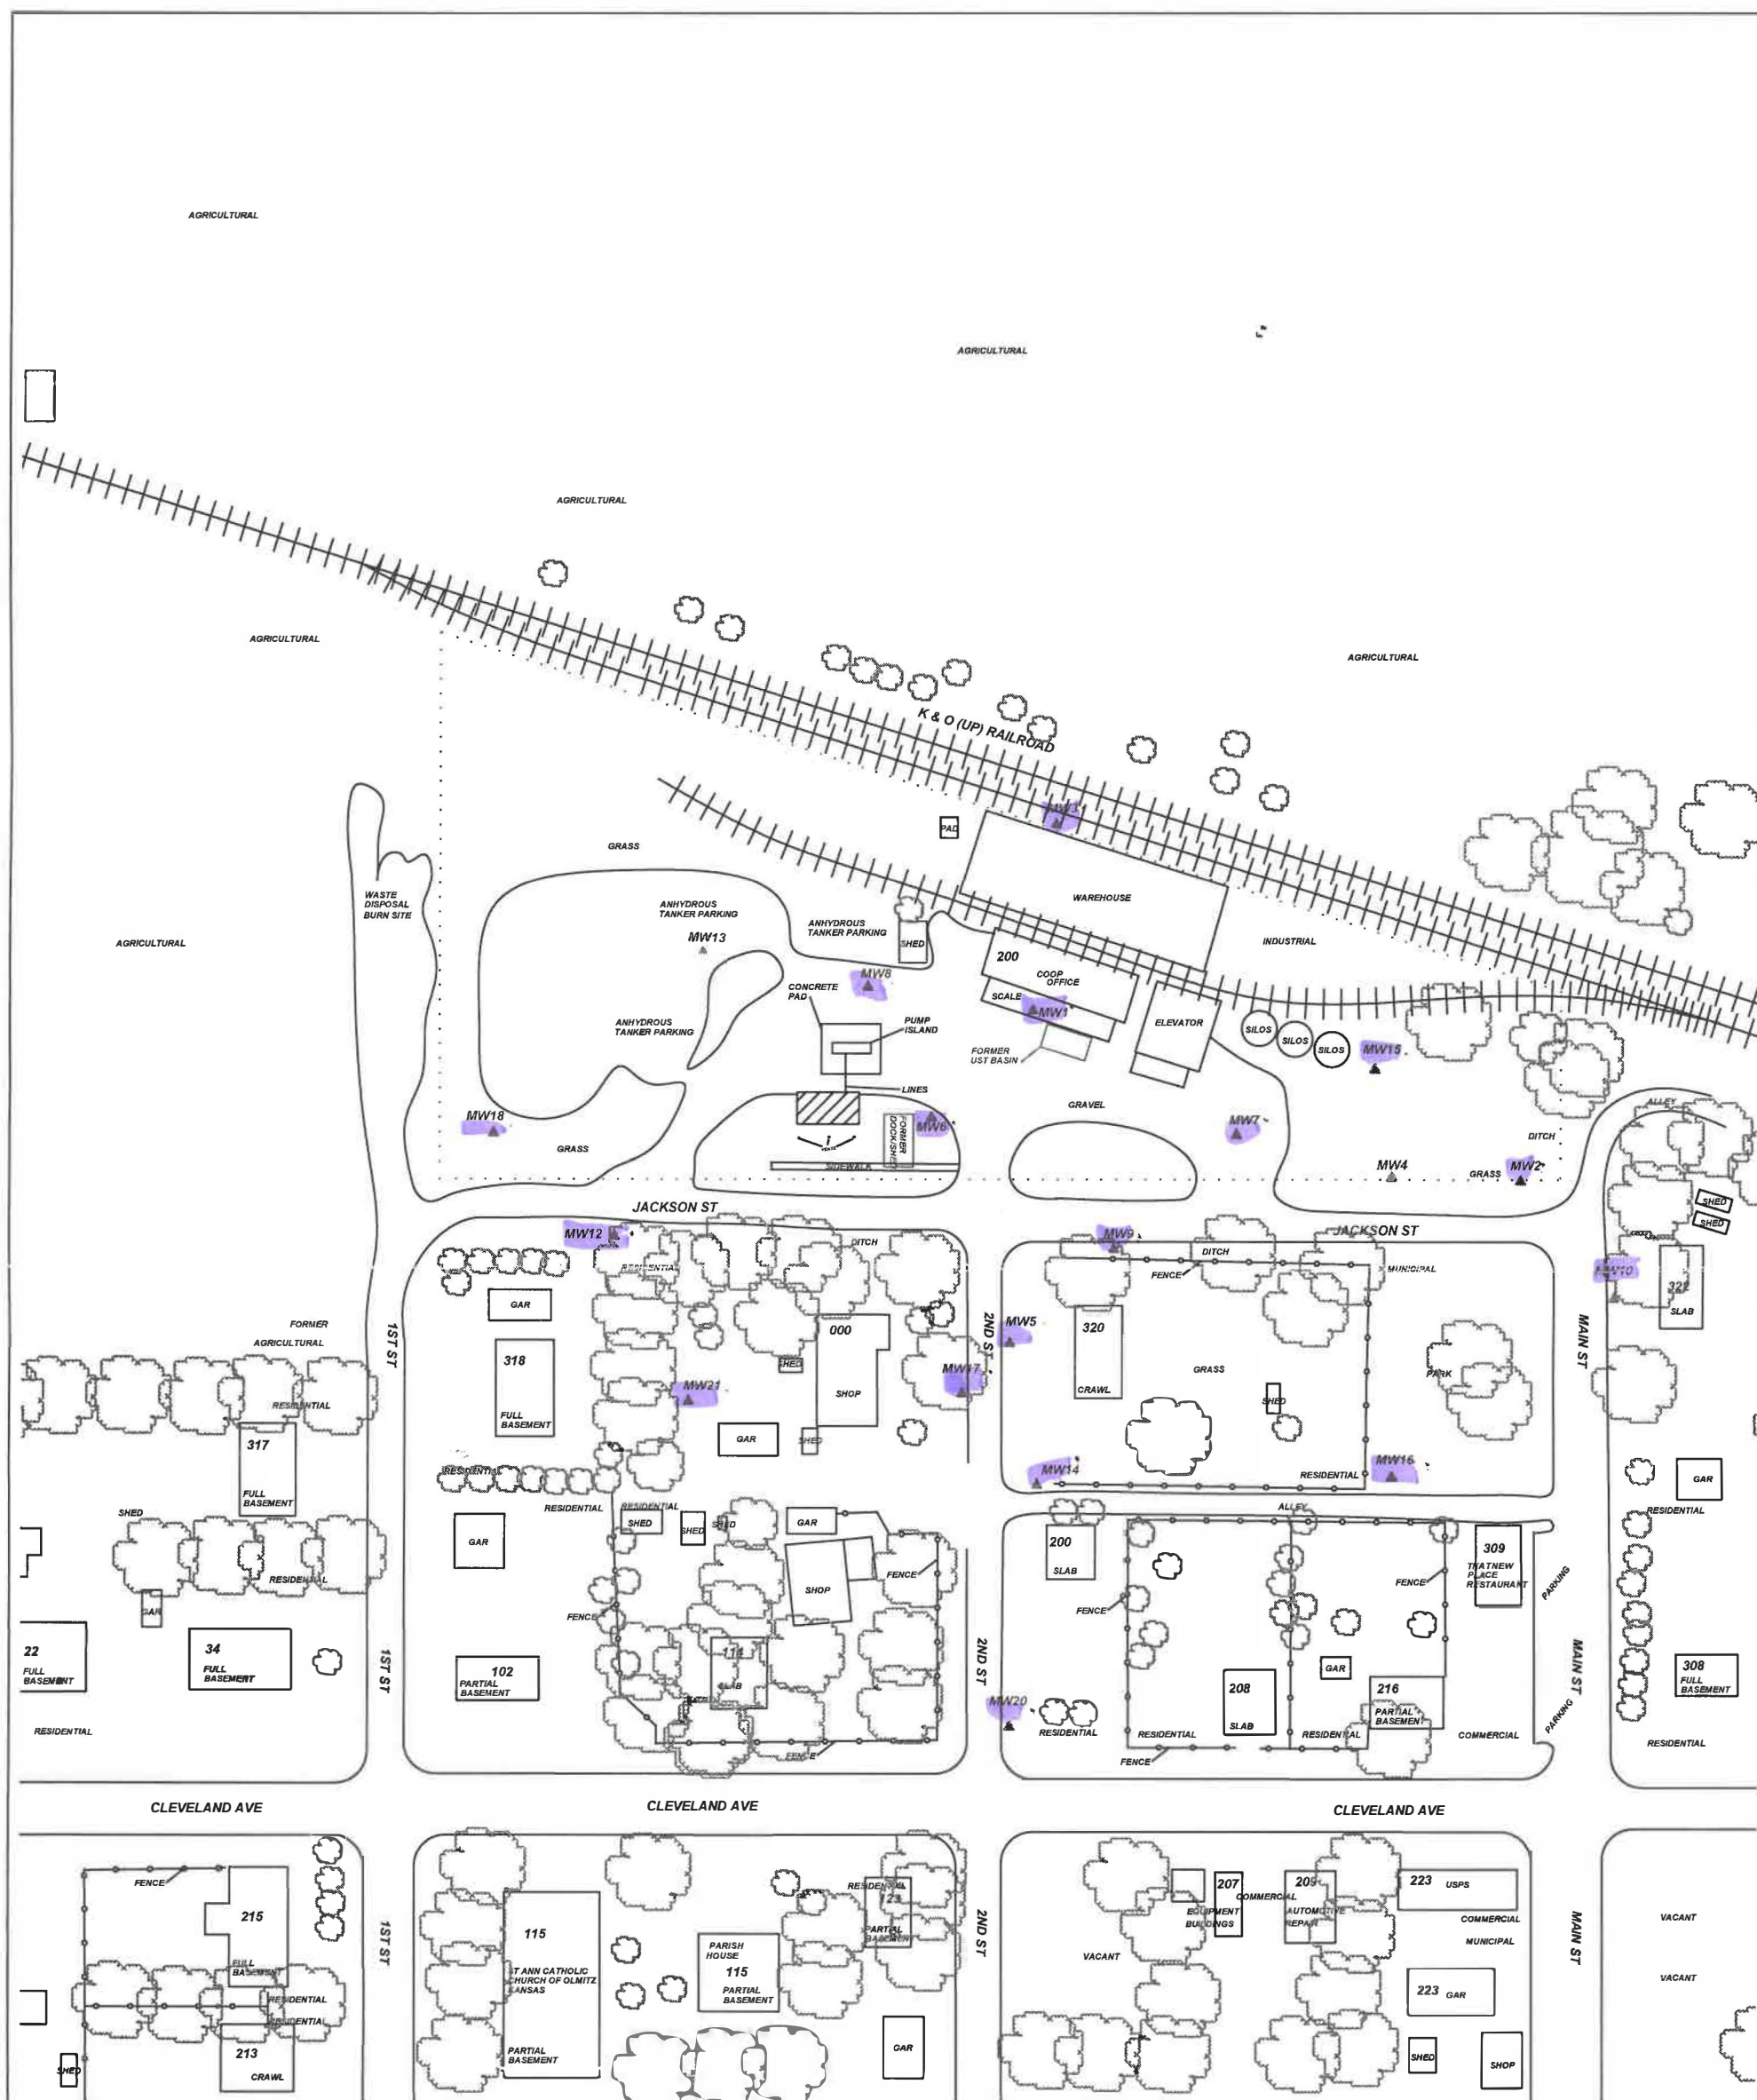

0 50 100



**ASSOCIATED
ENVIRONMENTAL
INC.**

••••• = **SUBJECT PROPERTY**

RECEIVED
APR 07 2023
BUREAU OF WATER