


WATER WELL RECORD Form WWC-5 KSA 82a-1212 ID No.

INSTRUCTIONS: Use typewriter or ball point pen. **PLEASE PRESS FIRMLY** and **PRINT** clearly. Please fill in blanks, underline or circle the correct answers. Send top three copies to Kansas Department of Health and Environment, Bureau of Water, Topeka, Kansas 66620-0001. Telephone 785-296-5524. Send one to **WATER WELL OWNER** and retain one for your records. Fee of \$5.00 for each constructed well.

Sec. 1 Twp. 18S Rge. 15 W

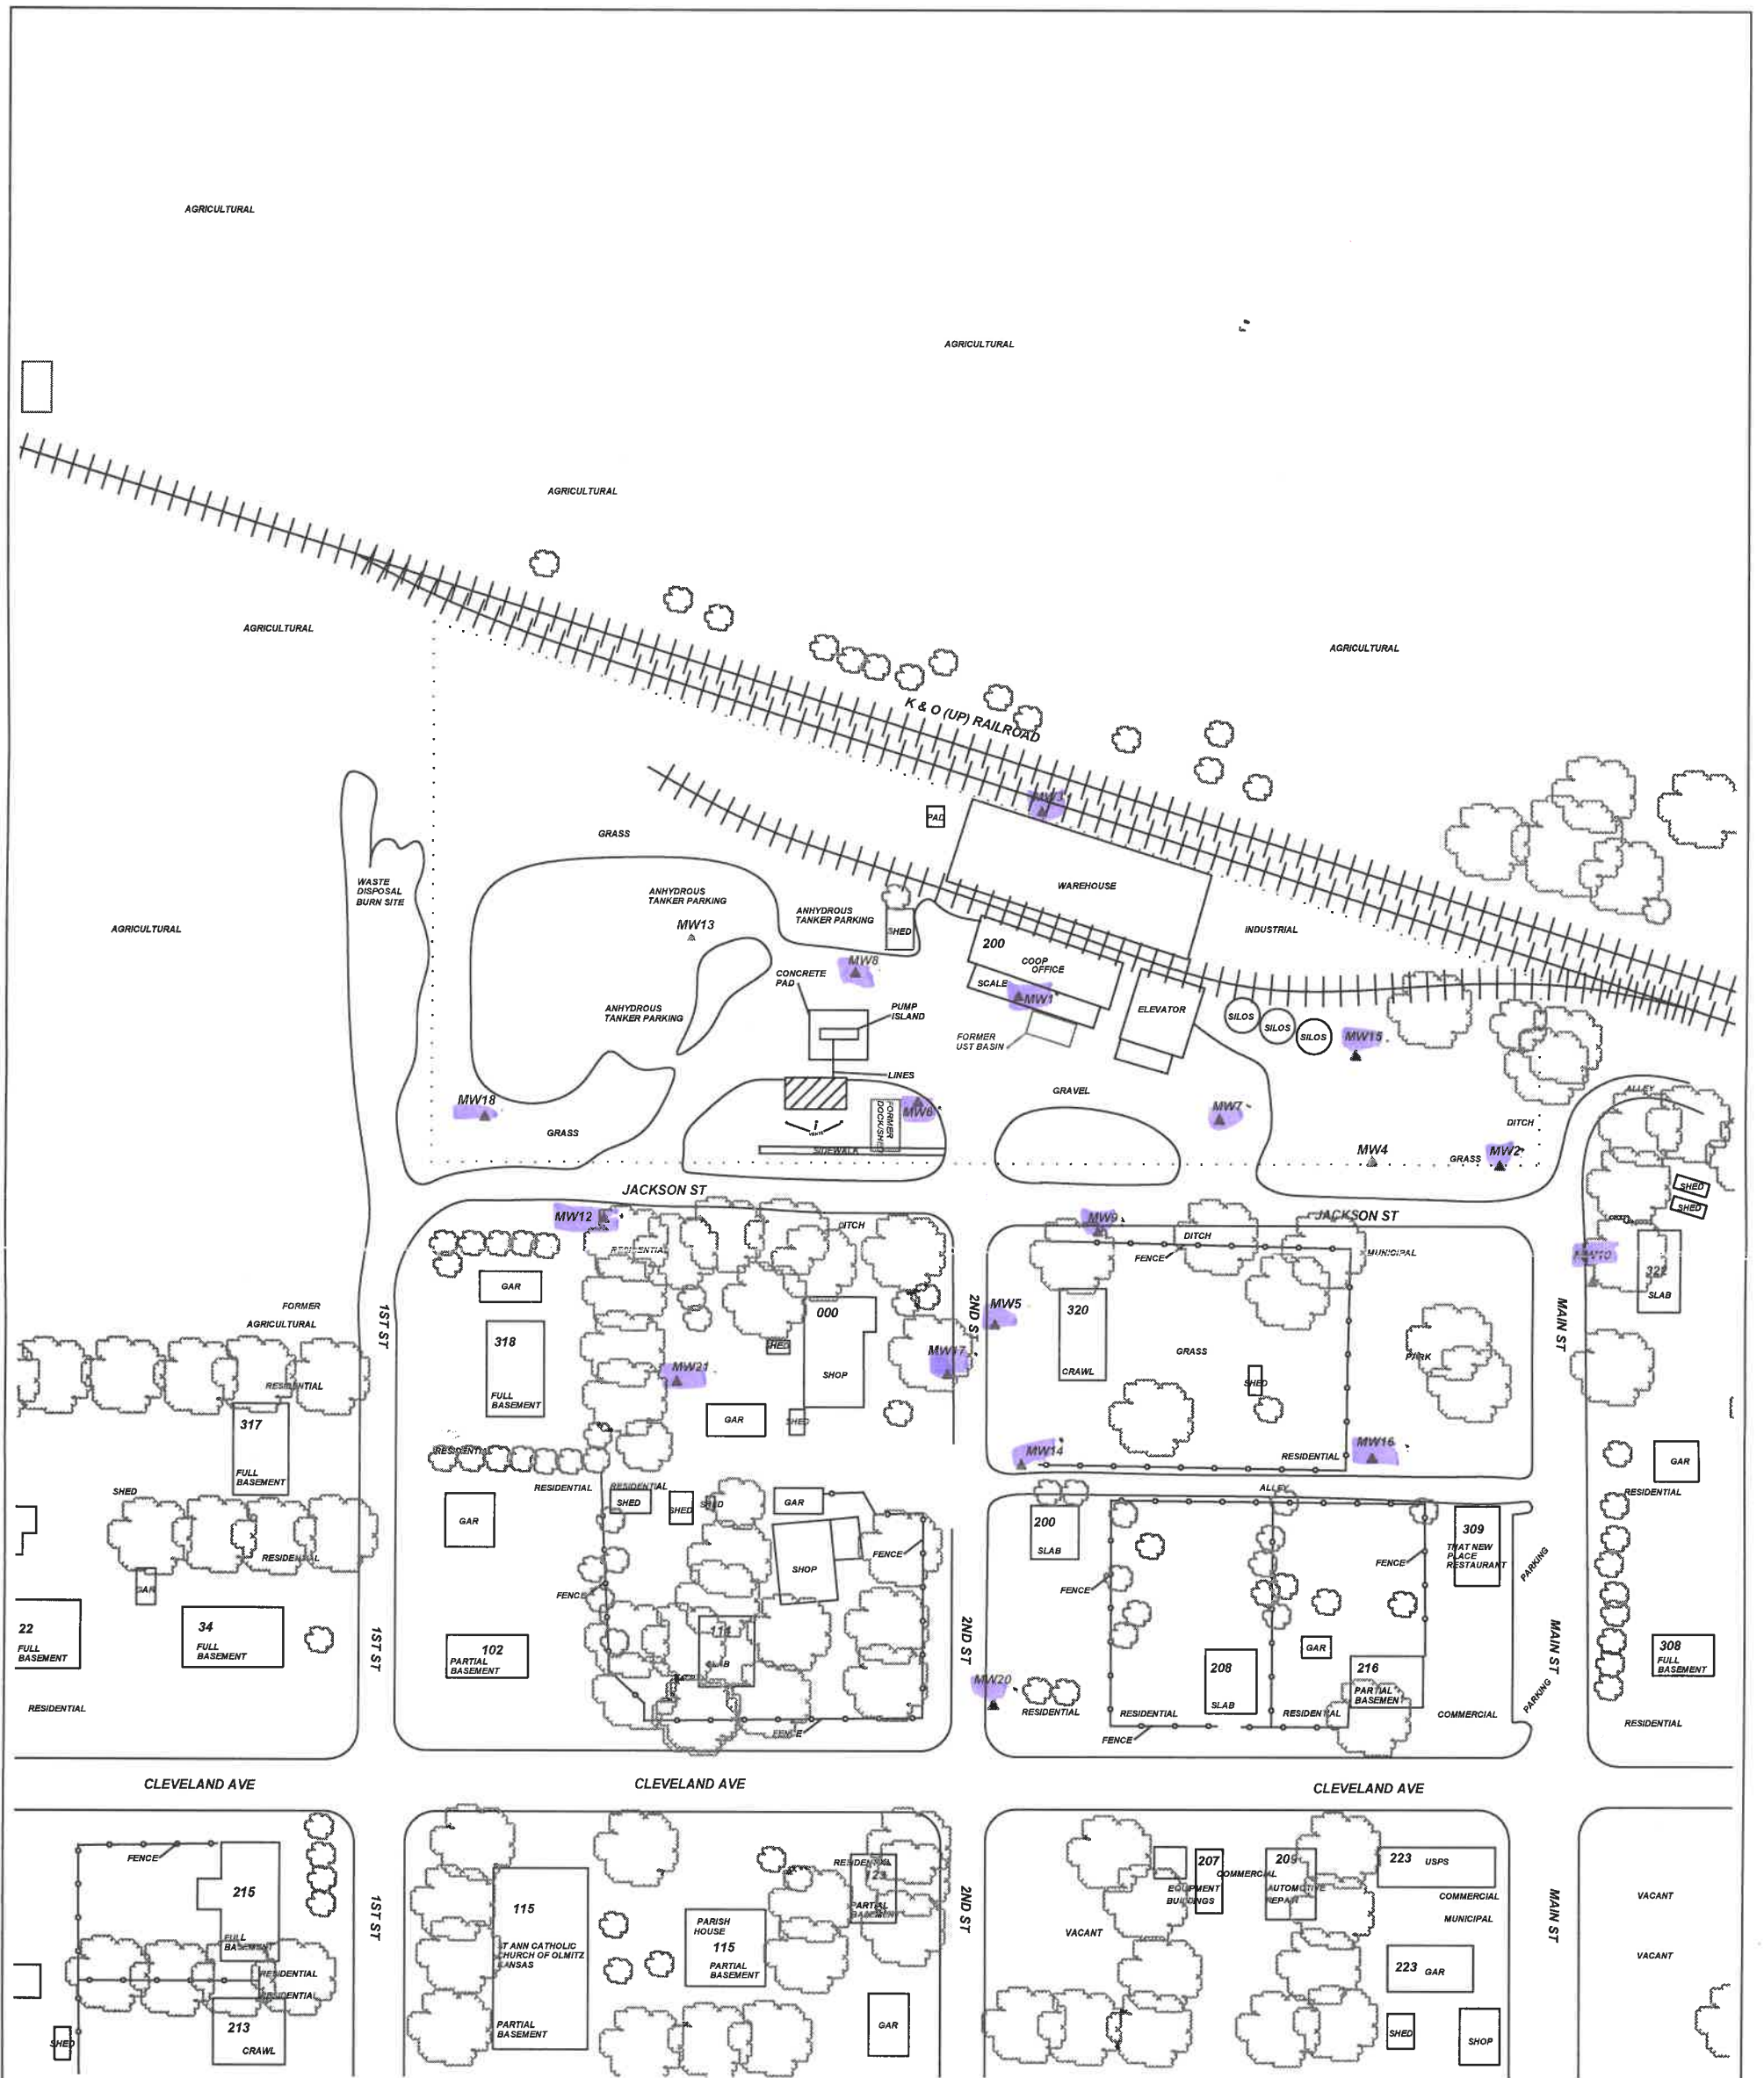

PROJECT: **UNITED AG SERVICES, INC.**
ADDRESS: **JACKSON STREET**
LOCATION: **OLMITZ, KS**
DRAWN BY: **C. ROE** DATE: **10/2/21**
REVISED BY: **B. STALNAKER** DATE: **2/9/23**
AEI JOB #: **TF539** KDHE JOB #: **U6-005-12455**

SCALE: **1" = 100'**
0 50 100

NOTES:

TITLE: **FIGURE 2.2
AREA BASE MAP
500' RADIUS**
**ASSOCIATED
ENVIRONMENTAL
INC.**

LEGEND:
= 1-8K GALS. DYED DIESEL / 1-8K GALS. CLEAR DIESEL / 1-8K GALS. E10 GASOLINE, PRODUCT LINES, VENTS, & DISPENSERS
= MONITORING WELL
= PLUGGED/DESTROYED WELL
= SUBJECT PROPERTY
**RECEIVED
APR 07 2023
BUREAU OF WATER**