


[illegible]

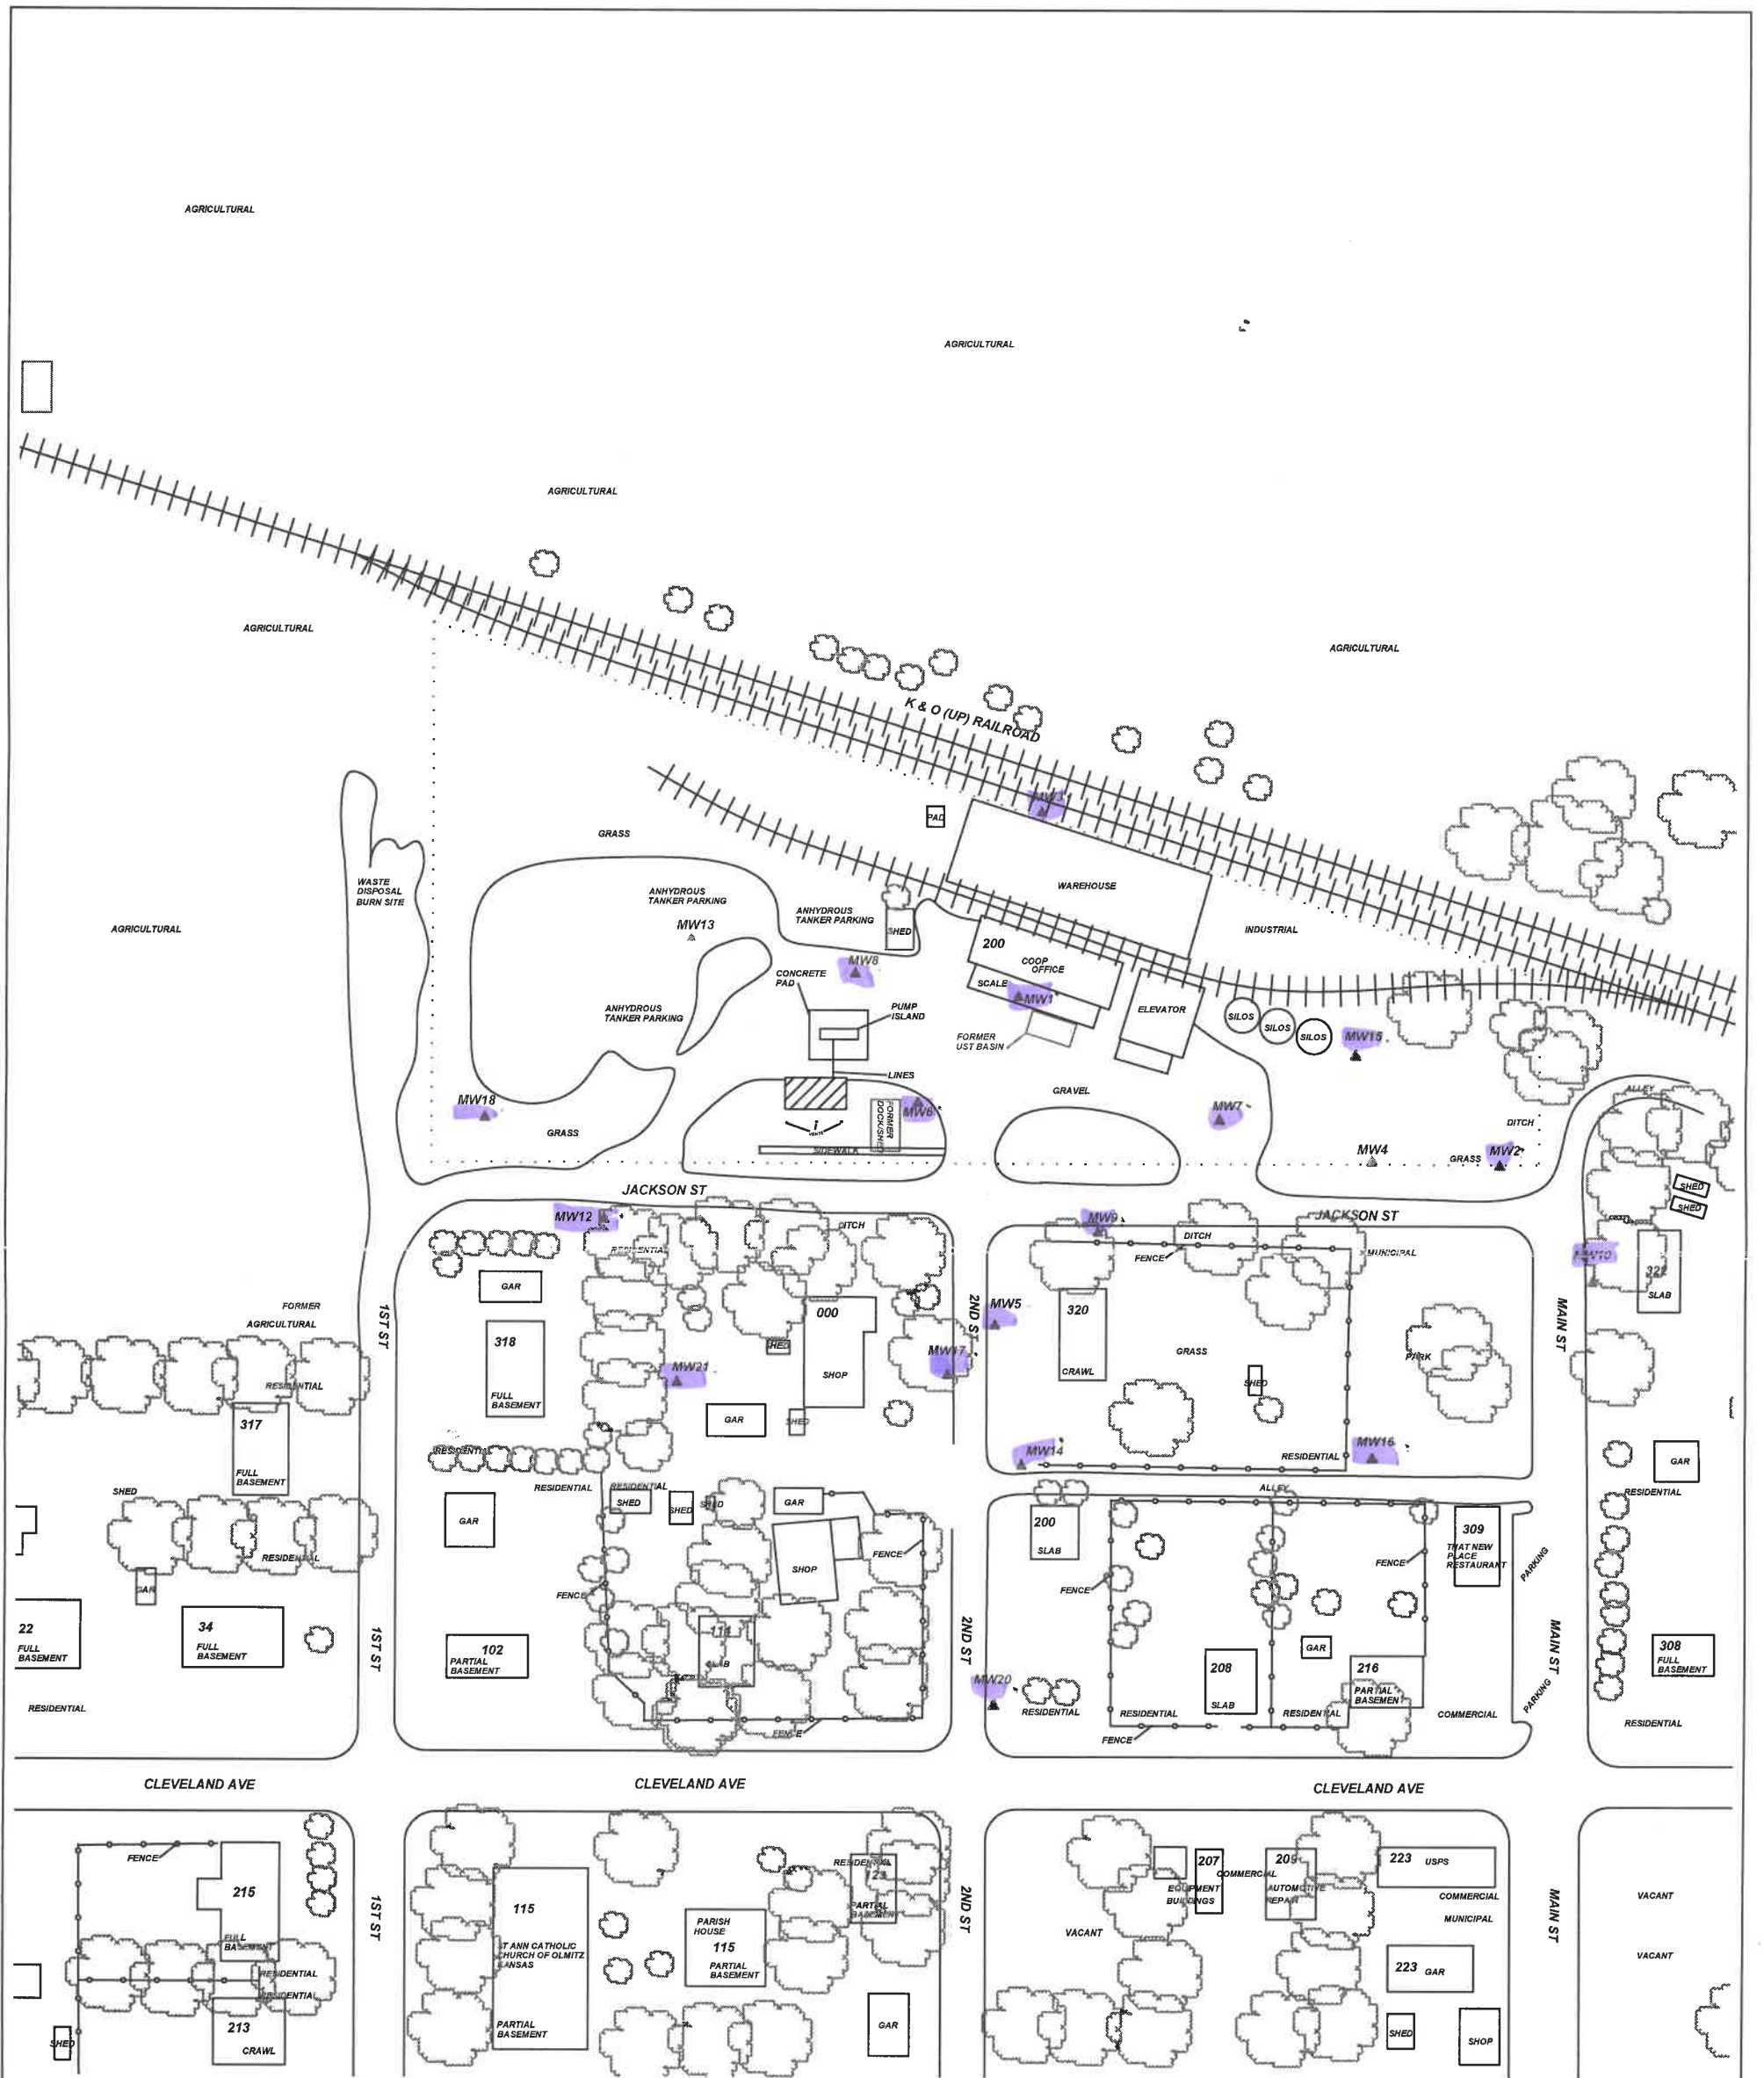

Sec. 1 Twp. 18S Rge. 15 W



PROJECT: **UNITED AG SERVICES, INC.**

ADDRESS: **JACKSON STREET**

LOCATION: **OLMITZ, KS**

DRAWN BY: **C. ROE** DATE: **10/2/21**

REVISED BY: **B. STALNAKER** DATE: **2/9/23**

AEI JOB #: **TF539** KDHE JOB #: **U6-005-12455**

SCALE: **1" = 100'**

0 50 100

NOTES:

TITLE: **FIGURE 2.2  
AREA BASE MAP  
500' RADIUS**

**ASSOCIATED  
ENVIRONMENTAL  
INC.**

LEGEND:

= 1-8K GALS. DYED DIESEL / 1-8K GALS. CLEAR DIESEL / 1-8K GALS. E10 GASOLINE, PRODUCT LINES, VENTS, & DISPENSERS

= MONITORING WELL

= PLUGGED/DESTROYED WELL

= SUBJECT PROPERTY

**RECEIVED  
APR 07 2023  
BUREAU OF WATER**