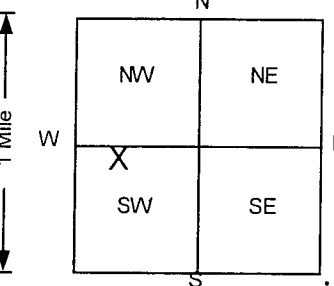


1 LOCATION OF WATER WELL:		Fraction	Section Number	Township Number	Range Number
County: Barton		NE 1/4 NW 1/4 SW 1/4	29	T 18 S	R 15 E
Distance and direction from nearest town or city street address of well if located within city? 805 N. Main; Albert, Kansas					
2 WATER WELL OWNER: Great Bend Coop - Albert Station					
RR#, St. Address, Box # : P.O. Box 68					
City, State, ZIP Code : Great Bend, Kansas 67530					
Board of Agriculture, Division of Water Resources Application Number:					
3 LOCATE WELL'S LOCATION WITH AN "X" IN SECTION BOX:		4 DEPTH OF COMPLETED WELL: 20 ft. ELEVATION: 1916.48			
		Depth(s) Groundwater Encountered 1. ft. 2. ft. 3. ft. WELL'S STATIC WATER LEVEL ft. below land surface measured on mo/day/yr Pump test data: Well water was NA ft. after hours pumping gpm Est. Yield NA gpm: Well water was ft. after hours pumping gpm Bore Hole Diameter 8 in. to 20 ft. and in. to ft. WELL WATER TO BE USED AS: 5 Public water supply 8 Air conditioning 11 Injection well 1 Domestic 3 Feedlot 6 Oil field water supply 9 Dewatering 12 Other (Specify below) 2 Irrigation 4 Industrial 7 Lawn and garden only 10 Monitoring well Was a chemical/bacteriological sample submitted to Department? Yes No If yes, mo/day/yr sample was submitted Water Well Disinfected? Yes No			
5 TYPE OF BLANK CASING USED:					
1 Steel 3 RMP (SR) 5 Wrought iron 8 Concrete tile CASING JOINTS: Glued Clamped					
2 PVC 4 ABS 6 Asbestos-Cement 9 Other (specify below) Welded					
7 Fiberglass Threaded					
Blank casing diameter 2 in. to 10 ft. Dia in. to ft. Dia in. to ft. Casing height above land surface -6.6 in. weight lbs./ft. Wall thickness or gauge No. SCH. 40					
TYPE OF SCREEN OR PERFORATION MATERIAL					
1 Steel 3 Stainless steel 5 Fiberglass 7 PVC 10 Asbestos-cement					
2 Brass 4 Galvanized steel 6 Concrete tile 8 RMP (SR) 11 Other (specify)					
9 ABS 12 None used (open hole)					
SCREEN OR PERFORATION OPENINGS ARE:					
1 Continuous slot 3 Mill slot 5 Gauzed wrapped 8 Saw cut 11 None (open hole)					
2 Louvered shutter 4 Key punched 6 Wire wrapped 9 Drilled holes					
7 Torch cut 10 Other (specify)					
SCREEN-PERFORATED INTERVALS: From 10 ft. to 20 ft. From ft. to ft.					
GRAVEL PACK INTERVALS: From 9 ft. to 20 ft. From ft. to ft.					
6 GROUT MATERIAL: 1 Neat cement 2 Cement grout 3 Bentonite 4 Other					
Grout Intervals: From 0 ft. to 1 ft. From 1 ft. to 9 ft. From ft. to ft.					
What is the nearest source of possible contamination:					
1 Septic tank 4 Lateral lines 7 Pit privy 10 Livestock pens 14 Abandoned water well					
2 Sewer lines 5 Cess pool 8 Sewage lagoon 11 Fuel storage 15 Oil well/Gas well					
3 Watertight sewer lines 6 Seepage pit 9 Feedyard 12 Fertilizer storage 16 Other (specify below)					
Direction from well? NW 13 Insecticide storage 16 Underground Storage					
How many feet? 85					
FROM TO LITHOLOGIC LOG FROM TO PLUGGING INTERVALS					
0	0.06	Gravel,			
0.06	5	Clay, Brown			
5	9	Clay, Brown			
9	13	Clay, Gray Brown			
13	17	Silt, Brown			
17	20	Clay, Brown			
MW3, Tag # 00339135, Flushmount					
Project Name: Great Bend Coop - Albert Station					
GeoCore # 935, KDHE # U6 005 12788					
CONTRACTOR'S OR LANDOWNER'S CERTIFICATION: This water well was (1) constructed, (2) reconstructed, or (3) plugged under my jurisdiction and was completed on (mo/day/year) 1/15/02 and this record is true to the best of my knowledge and belief.					
Kansas Water Well Contractor's License No. 527 This Water Well Record was completed on (mo/day/yr) 2/7/02					
under the business name of GeoCore Services, Inc. by (signature)					