

revised  
MW16

**WATER WELL PLUGGING RECORD Form WWC-5P KSA 82a-1212 ID NO.**


<b>1 LOCATION OF WATER WELL:</b> County: <b>BARTON</b>	Fraction <b>SE ¼ SE ¼ NW ¼ NW ¼</b>	Section Number <b>1</b>	Township Number <b>T 18 S</b>	Range Number <b>15</b> <input type="checkbox"/> E <input checked="" type="checkbox"/> W
---	--	----------------------------	----------------------------------	--

Street/Rural Address of Well Location; if unknown, distance & direction from nearest town or intersection: If at owner's address, check here  **320 2ND ST OLMITZ, KS 67564**

**Global Positioning Systems (GPS) information:**  
 Latitude: \_\_\_\_\_ (in decimal degrees)  
 Longitude: \_\_\_\_\_ (in decimal degrees)  
 Elevation: **2021.63**  
 Horizontal Datum:  WGS84,  NAD83,  NAD27  
 Collection Method: \_\_\_\_\_

**2 WATER WELL OWNER: AGRI TRAILS COOP**  
 RR#, St. Address, Box #: **PO BOX 157**  
 City, State ZIP Code: **HOPE, KS 67451-0157**

GPS unit (Make/Model: \_\_\_\_\_)  
 Digital Map/Photo,  Topographic Map,  Land Survey  
 Est. Accuracy:  < 3 m,  3-5 m,  5-15 m,  > 15 m

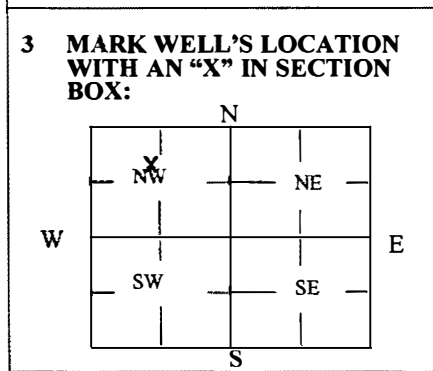

**4 DEPTH OF WELL** 29.45 **ft.**  
 WELL'S STATIC WATER LEVEL 21.80 **ft.**  
 WELL WAS USED AS:  
 Domestic  Public Water Supply  Dewatering  
 Irrigation  Oil Field Water Supply  Monitoring  
 Feedlot  Domestic (Lawn & Garden)  Injection Well  
 Industrial  Air Conditioning  Other \_\_\_\_\_  
 Was a chemical/bacteriological sample submitted to Department? Yes  No

**5 TYPE OF BLANK CASING USED:**

Steel  RMP (SR)  Wrought  Fiberglass  Other (Specify below) \_\_\_\_\_  
 PVC  ABS  Asbestos-Cement  Concrete Tile

Blank casing diameter 2 in. Was casing pulled? Yes  No  If yes, how much 1.5'  
 Casing height above or below land surface \_\_\_\_\_ in.

**6 GROUT PLUG MATERIAL:**  Neat cement  Cement grout  Bentonite  Other GRASS 0-0.5


Grout Plug Intervals: From 0.5 ft. to 29.45 ft., From \_\_\_\_\_ ft. to \_\_\_\_\_ ft., From \_\_\_\_\_ ft. to \_\_\_\_\_ ft.

What is the nearest source of possible contamination:  
 Septic tank  Seepage pit  Fuel storage  Other (specify below) \_\_\_\_\_  
 Sewer lines  Pit privy  Fertilizer storage  
 Watertight sewer lines  Sewage lagoon  Insecticide storage  
 Lateral lines  Feedyard  Abandoned water well  Oil well/Gas well  
 Cess pool  Livestock pens


Direction from well? WEST  
 How many feet? 150



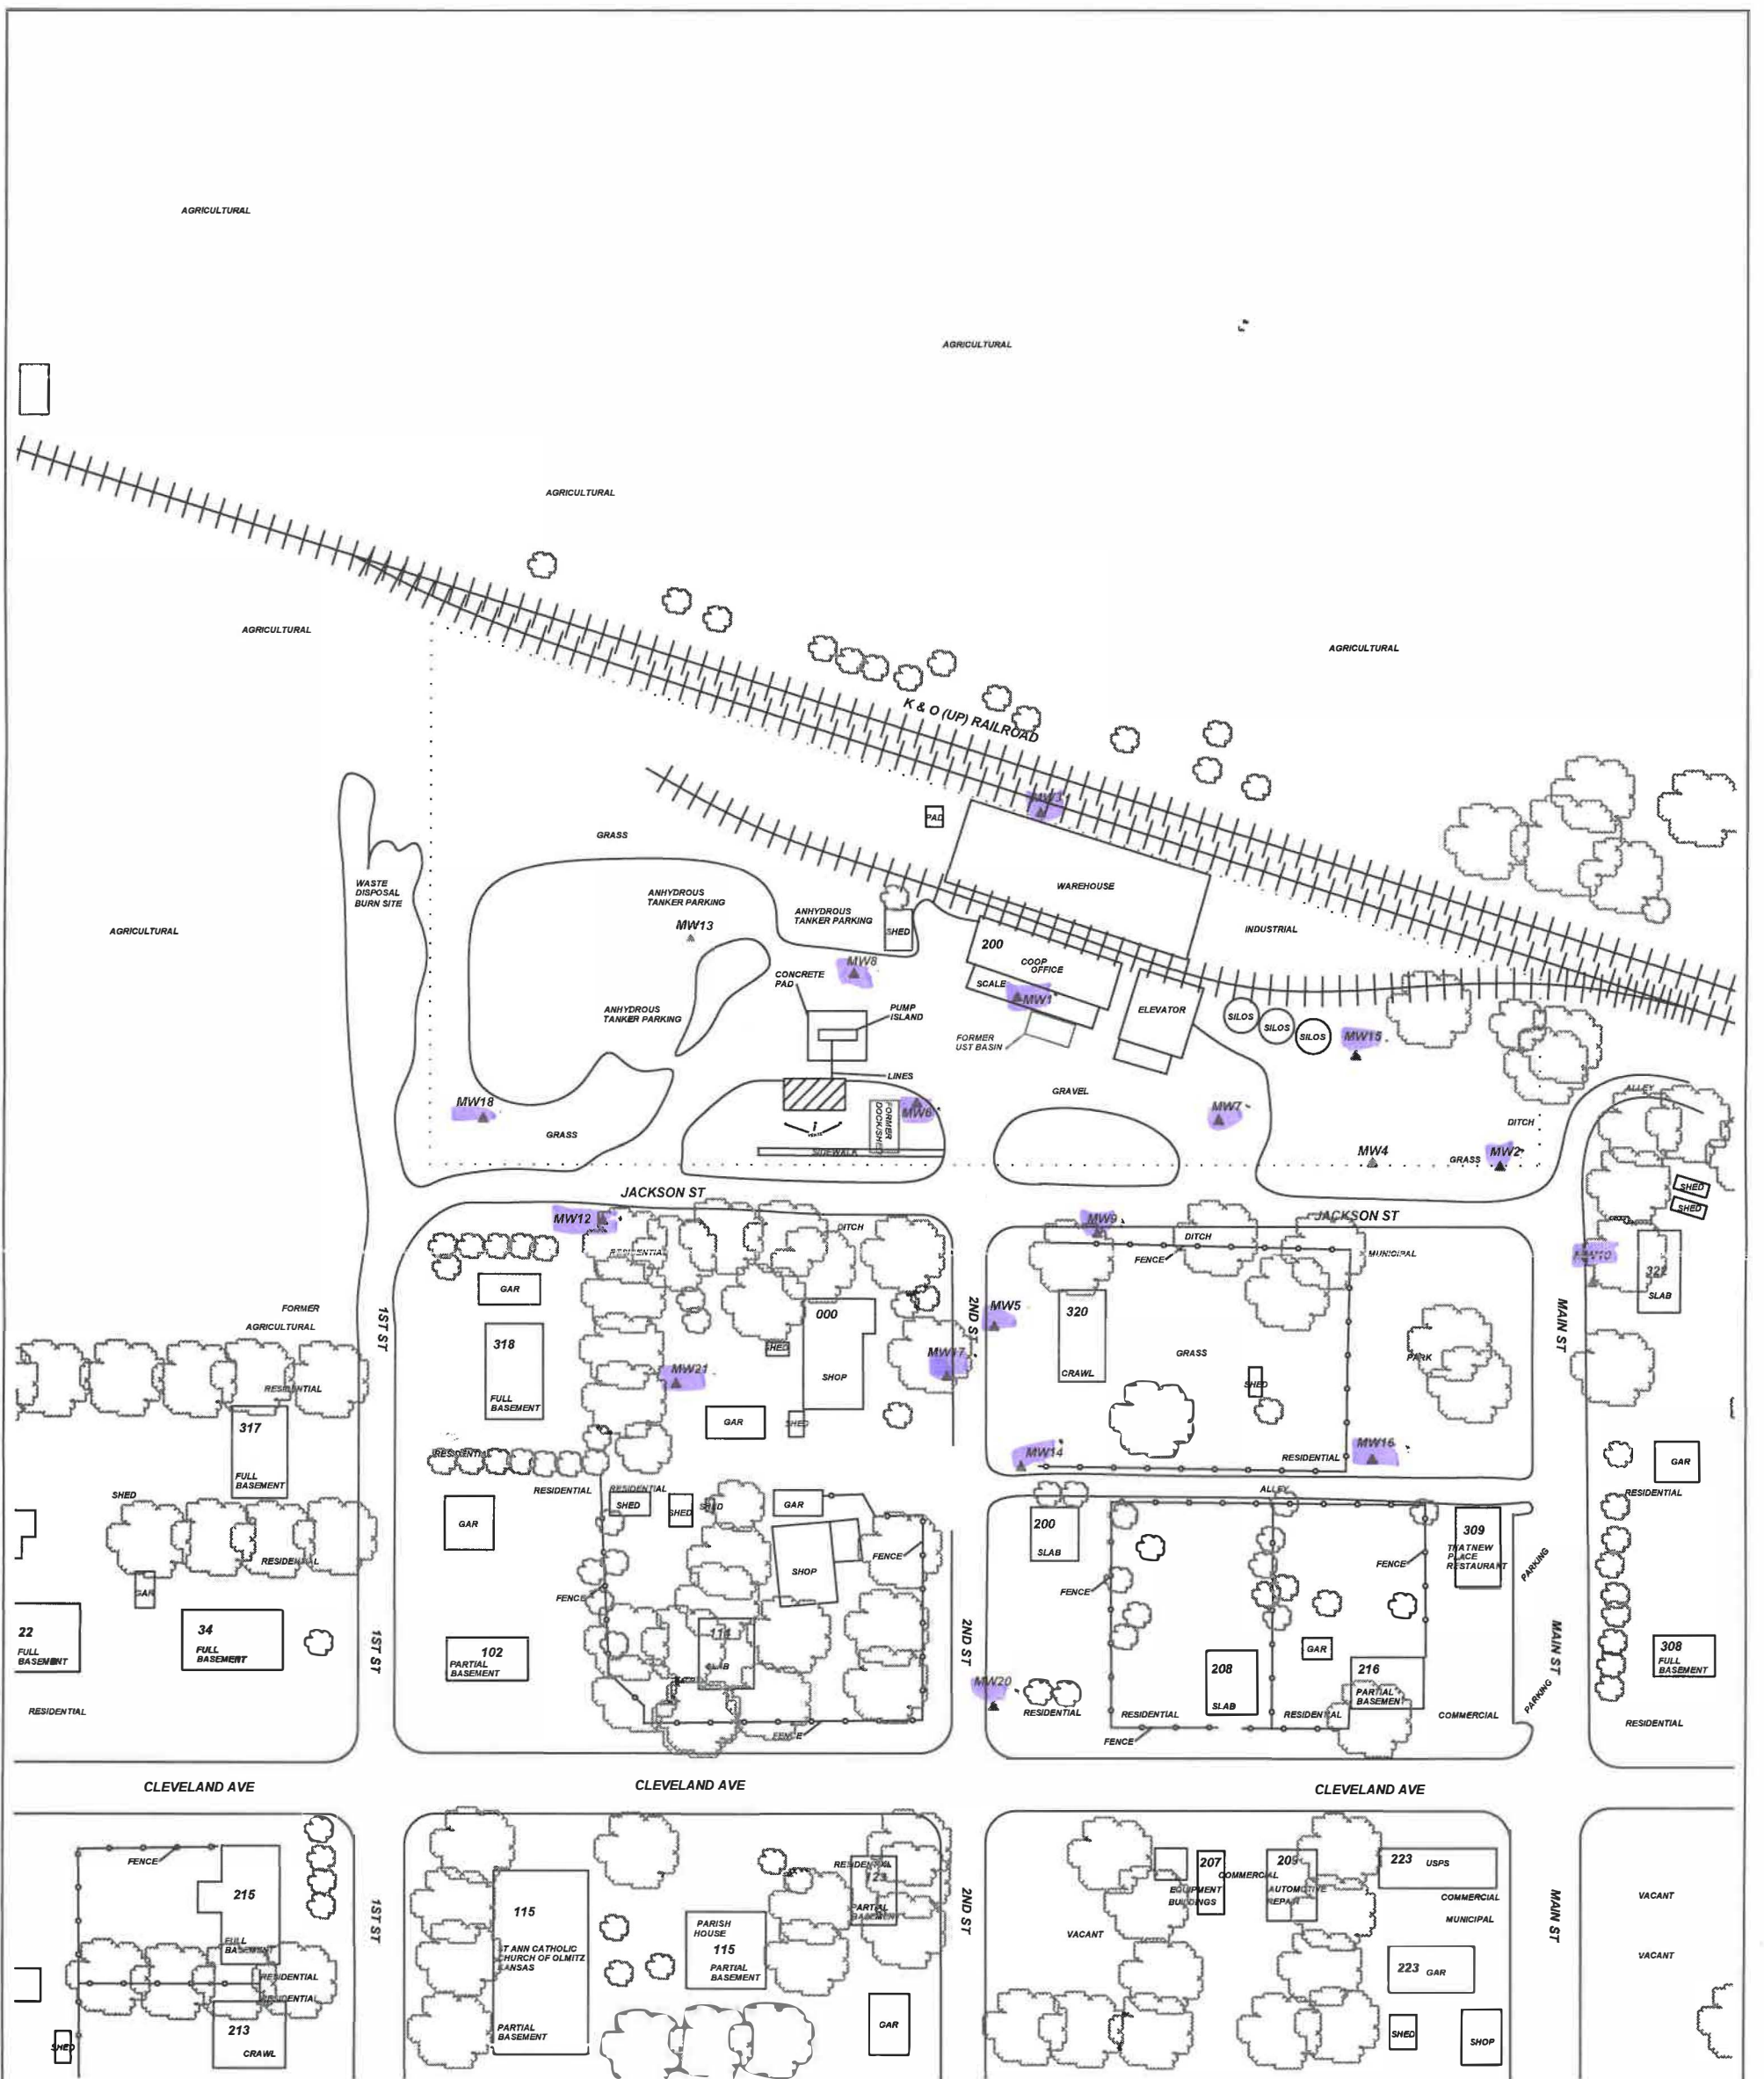


FROM	TO	PLUGGING MATERIALS	FROM	TO	PLUGGING MATERIALS
0	0.5	TOPSOIL			
0.5	29.45	BENTONITE			

**7 CONTRACTOR'S OR LANDOWNER'S CERTIFICATION:** This water well was plugged under my jurisdiction and was completed on (mo/day/year) 9/26/22 and this record is true to the best of my knowledge and belief. Kansas Water Well Contractor's License No. 585. This Water Well Record was completed on (mo/day/year) 10/3/22 under the business name of ASSOCIATED ENVIRONMENTAL INC. by (signature) \_\_\_\_\_



**PROJECT:** UNITED AG SERVICES, INC.  
**ADDRESS:** JACKSON STREET  
**LOCATION:** OLMITZ, KS  
**DRAWN BY:** C. ROE **DATE:** 10/2/21  
**REVISED BY:** B. STALNAKER **DATE:** 2/9/23  
**AEI JOB #:** TF539 **KDHE JOB #:** U6-005-12455  
**SCALE:** 1" = 100'  
 0 50 100

**TITLE:** FIGURE 2.2  
 AREA BASE MAP  
 500' RADIUS  
 **ASSOCIATED ENVIRONMENTAL INC.**

**LEGEND:**  
 = 1-8K GALS. DYED DIESEL / 1-8K GALS. CLEAR DIESEL / 1-8K GALS. E10 GASOLINE, PRODUCT LINES, VENTS, & DISPENSERS  
 = MONITORING WELL  
 = PLUGGED/DESTROYED WELL  
 = SUBJECT PROPERTY  


**RECEIVED**  
**APR 07 2023**  
**BUREAU OF WATER**