


1 LOCATION OF WATER WELL:		Fraction	Section Number		Township Number		Range Number	
County:	Barton	SW ¼ NW ¼ SE ¼	28		T 18 S		R 15 E/W	

1¼ east of Albert, Ks.

Board of Agriculture, Division of Water Resources
Application Number: 6821

4 DEPTH OF COMPLETED WELL.....93..... ft. ELEVATION:

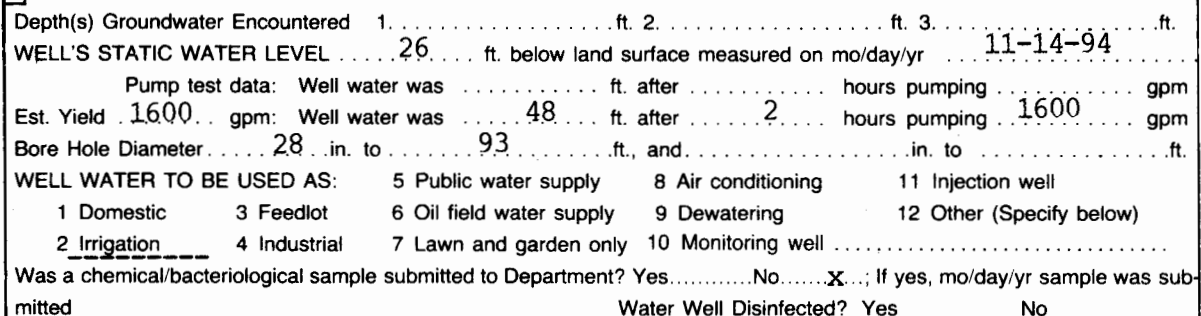

6 GROUT MATERIAL:				1 <u>Neat cement</u>	2 Cement grout	3 Bentonite	4 Other
Grout Intervals:				From 0 ... ft. to 20 ... ft.,	From	ft. to	ft. to
What is the nearest source of possible contamination:				10 Livestock pens			
1 Septic tank				4 Lateral lines	7 Pit privy	11 Fuel storage	14 Abandoned water well
2 Sewer lines				5 Cess pool	8 Sewage lagoon	12 Fertilizer storage	15 <u>Oil well/Gas well</u>
3 Watertight sewer lines				6 Seepage pit	9 Feedyard	13 Insecticide storage	16 Other (specify below)
Direction from well?				east		How many feet?	500

[illegible]

7 CONTRACTOR'S OR LANDOWNER'S CERTIFICATION: This water well was (1) constructed, (2) reconstructed, or (3) plugged under my jurisdiction and was completed on (mo/day/year) 11-30-94 and this record is true to the best of my knowledge and belief. Kansas Water Well Contractor's License No. 134 This Water Well Record was completed on (mo/day/yr) 12-1-94 under the business name of Rosencrantz-Bemis bv (signature) [Signature]

INSTRUCTIONS: Use typewriter or ball point pen. PLEASE PRESS FIRMLY and PRINT clearly. Please fill in blanks, underline or circle the correct answers. Send top three copies to Kansas Department of Health and Environment, Bureau of Water, Topeka, Kansas 66620-0001. Telephone: 913-296-5545. Send one to WATER WELL OWNER and retain one for your records.