


1 LOCATION OF WATER WELL:	Fraction	Section Number	Township Number	Range Number
County: Rush	NE 1/4 NE 1/4 NE 1/4	23	T 18 S	R 16 E (W)

Distance and direction from nearest town or city street address of well if located within city?
 Approximately 3 1/2 miles south of Otis

2 WATER WELL OWNER: City of Otis
 RR#, St. Address, Box # : P.O. Box 326
 City, State, ZIP Code : Otis, KS 67565
 Board of Agriculture, Division of Water Resources
 Application Number:

3 LOCATE WELL'S LOCATION WITH AN "X" IN SECTION BOX:	4 DEPTH OF COMPLETED WELL	105	ft. ELEVATION:	unknown
--	---------------------------	-----	----------------	---------

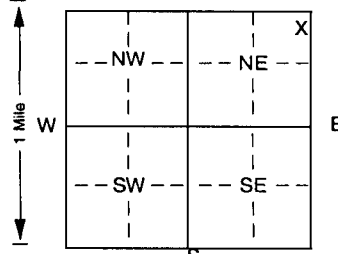

Depth(s) Groundwater Encountered 1 _____ ft. 2 _____ ft. 3 _____ ft.
 WELL'S STATIC WATER LEVEL 24 ft. below land surface measured on mo/day/yr 7-28-04
 Pump test data: Well water was not checked ft. after _____ hours pumping _____ gpm
 Est. Yield unknown gpm: Well water was _____ ft. after _____ hours pumping _____ gpm
 Bore Hole Diameter 30 in. to 101 ft., and _____ in. to _____ ft.
 WELL WATER TO BE USED AS: (5) Public water supply 8 Air conditioning 11 Injection well
 1 Domestic 3 Feedlot 6 Oil field water supply 9 Dewatering 12 Other (specify below)
 2 Irrigation 4 Industrial 7 Domestic (lawn & garden) 10 Monitoring well
 Was a chemical/bacteriological sample submitted to Department? Yes _____ No (checked) If yes, mo/day/yr sample was submitted
 Water Well Disinfected? Yes (checked) No

5 TYPE OF BLANK CASING USED:

(1) Steel	3 RMP (SR)	5 Wrought iron	8 Concrete tile	CASING JOINTS: Glued _____ Clamped _____
2 PVC	4 ABS	6 Asbestos-Cement	9 Other (specify below)	Welded (checked) _____
		7 Fiberglass		Threaded _____

Blank casing diameter 10 in. to 66 ft., Dia 10 in. to 88 ft., Dia 10 in. to 101 ft.
 Casing height above land surface 48 in., weight 40.21 lbs./ft. Wall thickness or gauge No .375

TYPE OF SCREEN OR PERFORATION MATERIAL:

1 Steel	(3) Stainless steel	5 Fiberglass	8 RMP (SR)	10 Asbestos-cement
2 Brass	4 Galvanized steel	6 Concrete tile	9 ABS	11 Other (specify)
				12 None used (open hole)

SCREEN OR PERFORATION OPENINGS ARE:

(1) Continuous slot	3 Mill slot	5 Gauzed wrapped	8 Saw cut	11 None (open hole)
2 Louvered shutter	4 Key punched	6 Wire wrapped	9 Drilled holes	
		7 Torch cut	10 Other (specify)	ft.

SCREEN-PERFORATED INTERVALS: From 66 ft. to 72 ft., From _____ ft. to _____ ft.
 From 88 ft. to 98 ft., From _____ ft. to _____ ft.
 GRAVEL PACK INTERVALS: From 62 ft. to 79 ft., From _____ ft. to _____ ft.
 From 84 ft. to 101 ft., From _____ ft. to _____ ft.

6 GROUT MATERIAL: 1 Neat cement (2) Cement grout 3 Bentonite 4 Other Benotnite Holeplug
 Compacted Soil
 Grout Intervals: From 0 ft. to 5 ft., From 5 ft. to 59 ft., From 59 - 62 ft. to 79 - 84 ft.
 What is the nearest source of possible contamination:
 1 Septic tank 4 Lateral lines 7 Pit privy 10 Livestock pens 14 Abandoned water well
 2 Sewer lines 5 Cess pool 8 Sewage lagoon 11 Fuel storage 15 Oil well/Gas well
 3 Watertight sewer lines 6 Seepage pit 9 Feedyard 12 Fertilizer storage 16 Other (specify below)
 13 Insecticide storage None known

Direction from well? _____ How many feet? _____

FROM	TO	LITHOLOGIC LOG	FROM	TO	PLUGGING INTERVALS
0	3	Topsoil			
3	17	Clay, dark brown			
17	22	Clay, tannish brown			
22	27	Clay, gray			
27	45	Sand and gravel, fine, medium, coarse			
45	65	Clay, blue-green			
65	68	Sand and gravel with clay			
68	75	Sand and gravel, fine, medium, coarse			
75	77	Clay, tannish orange			
77	81	Sand and gravel, fine, medium, coarse			
81	90	Clay, brown			
90	98	Sand and gravel, very fine, fine, medium			
98	101	Clay, white and red			

7 CONTRACTOR'S OR LANDOWNER'S CERTIFICATION: This water well was (1) constructed, (2) reconstructed, or (3) plugged under my jurisdiction and was completed on (mo/day/year) 7-28-04 and this record is true to the best of my knowledge and belief. Kansas Water Well Contractor's License No 185 This Water Well Record was completed on (mo/day/yr) 8-20-04 under the business name of Clarke Well & Equipment, Inc. by (signature) _____

INSTRUCTIONS: Use typewriter or ball point pen. PLEASE PRESS FIRMLY and PRINT clearly. Please fill in blanks, underline or circle the correct answers. Send top three copies to Kansas Department of Health and Environment, Bureau of Water, Topeka, Kansas 66620-0001. Telephone 785-296-5524. Send one to WATER WELL OWNER and retain one for your records. Fee of \$5.00 for each constructed well.