


1 LOCATION OF WATER WELL: Fraction Section Number Township Number Range Number  
 County: Rush SW 1/4 NE 1/4 26 18 16 E/W

Distance and direction from nearest town or city street address of well if located within city?

2 WATER WELL OWNER: Troy Schroeder  
 RR #, St. Address, Box #: 251 Box 9 Board of Agriculture, Division of Water Resources  
 City, State, ZIP Code: Albert, KS Application Number:

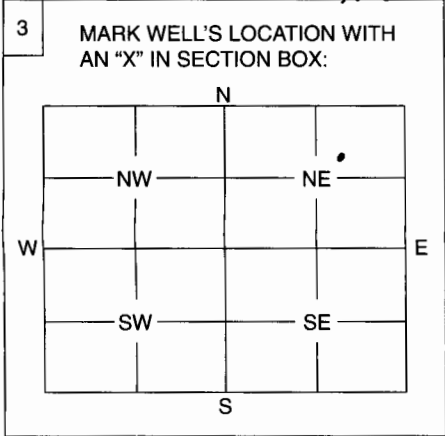

4 DEPTH OF WELL ..... 75 ft.  
 WELL'S STATIC WATER LEVEL ..... 39 ft.  
 WELL WAS USED AS:  
 Domestic      5 Public Water Supply      9 Dewatering  
 Irrigation      6 Oil Field Water Supply      10 Monitoring Well  
 Feedlot      7 Domestic (Lawn & Garden)      11 Injection Well  
 Industrial      8 Air Conditioning      12 Other .....

Was a chemical / bacteriological sample submitted to Department? Yes ..... No  .....  
 If yes, mo/day/yr sample was submitted .....

Water Well Disinfected: Yes  No .....

5 TYPE OF BLANK CASING USED:  
 Steel      3 RMP (SR)      5 Wrought      7 Fiberglass      9 Other (Specify below)  
 PVC      4 ABS      6 Asbestos-Cement      8 Concrete Tile .....

Blank casing diameter ..... in. Was casing pulled? Yes ..... No  ..... If yes, how much .....

Casing height above or below land surface ..... 36 in.

6 GROUT PLUG MATERIAL: 1 Neat cement      2 Cement grout       Bentonite      4 Other .....

Grout Plug Intervals: From 10 ft. to 3 ft., From ..... ft. to ..... ft., From ..... to ..... ft.

What is the nearest source of possible contamination:  
 Septic tank      6 Seepage pit      11 Fuel storage      16 Other (specify below)  
 Sewer lines      7 Pit privy      12 Fertilizer storage .....

Watertight sewer lines      8 Sewage lagoon      13 Insecticide storage .....

Lateral lines      9 Feedyard      14 Abandoned water well .....

Cess pool      10 Livestock pens      15 Oil well/Gas well .....

Direction from well? N & E How many feet? 20' + 60'

FROM	TO	PLUGGING MATERIALS
75	15	Sand
15	10	Compacted clays
10	3	Bentonite
3	0	Compacted Clays

7 CONTRACTOR'S OF LANDOWNER'S CERTIFICATION: This water well was plugged under my jurisdiction and was completed on (mo/day/year) 2-21-06 and this record is true to the best of my knowledge and belief. Kansas Water Well Contractor's License No. .... This Water Well Record was completed on (mo/day/year) .....

by (signature) Troy Schroeder

INSTRUCTIONS: Use typewriter or ball point pen. Please press firmly and print clearly. Please fill in blanks, underline or circle the correct answers. Send top three copies to Kansas Department of Health and Environment, Bureau of Water, Geology Section, 1000 SW Jackson St., Ste. 420, Topeka, Kansas 66612-1367. Telephone: 785/296-5522. Send one to Water Well Owner and retain one for your records.