


1 LOCATION OF WATER WELL:	Fraction	Section Number	Township Number	Range Number
County: <u>Rush</u>	<u>NW 1/4 NE 1/4 NW 1/4</u>	<u>20</u>	<u>18</u>	<u>16</u> EW

Distance and direction from nearest town or city street address of well if located within city?
1 1/2 West, 1/2 North of Shaffer

2 WATER WELL OWNER:	NOT CORRECT James Huenergardt 231 E. 12th Hays, Ks. 67601
RR #, St. Address, Box #:	HAVERN O. HUENERGARDT - BUSINESS + MAIL 8006 E LEHIGH AVE DENVER, COLO. 80237
City, State, ZIP Code	Board of Agriculture, Division of Water Resources Application Number:

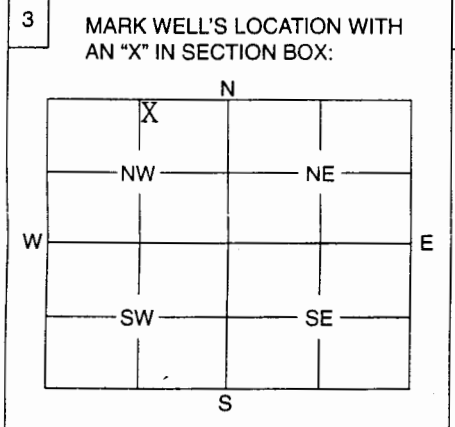

4 DEPTH OF WELL 65 1/2 ft.

WELL'S STATIC WATER LEVEL 26 ft.

WELL WAS USED AS:

1 Domestic	5 Public Water Supply	9 Dewatering
2 Irrigation	6 Oil Field Water Supply	10 Monitoring Well
3 Feedlot	7 Domestic (Lawn & Garden)	11 Injection Well
4 Industrial	8 Air Conditioning	12 Other

Was a chemical / bacteriological sample submitted to Department? Yes No X.....
 If yes, mo/day/yr sample was submitted

Water Well Disinfected: Yes HTH No

5 TYPE OF BLANK CASING USED:

1 Steel	3 RMP (SR)	5 Wrought	7 Fiberglass	9 Other (Specify below)
2 PVC	4 ABS	6 Asbestos-Cement	8 Concrete Tile

Blank casing diameter 16 in. Was casing pulled? Yes No X..... If yes, how much

Casing height above or below land surface 36 in.

6 GROUT PLUG MATERIAL: 1 Neat cement 2 Cement grout 3 Bentonite 4 Other

Grout Plug Intervals: From 26 ft. to 3 ft., From ft. to ft., From to ft.

What is the nearest source of possible contamination:

1 Septic tank	6 Seepage pit	11 Fuel storage	16 Other (specify below)
2 Sewer lines	7 Pit privy	12 Fertilizer storage None
3 Watertight sewer lines	8 Sewage lagoon	13 Insecticide storage	
4 Lateral lines	9 Feedyard	14 Abandoned water well	
5 Cess pool	10 Livestock pens	15 Oil well/Gas well	

Direction from well? How many feet?

FROM	TO	PLUGGING MATERIALS
<u>65 1/2</u>	<u>26</u>	<u>Chlorinated gravel</u>
<u>26</u>	<u>3</u>	<u>Cement</u>
<u>3</u>	<u>0</u>	<u>Top soil</u>

RECEIVED

JUL 31 2006

BUREAU OF WATER

CORRECTED

7 CONTRACTOR'S OF LANDOWNER'S CERTIFICATION: This water well was plugged under my jurisdiction and was completed on (mo/day/year) 5-25-06 and this record is true to the best of my knowledge and belief. Kansas Water Well Contractor's License No. 134 This Water Well Record was completed on (mo/day/year) 6-22-06 under the business name of Rosencrantz - Bemis by (signature) Cherem Oleg

INSTRUCTIONS: Use typewriter or ball point pen. Please press firmly and print clearly. Please fill in blanks, underline or circle the correct answers. Send top three copies to Kansas Department of Health and Environment, Bureau of Water, Geology Section, 1000 SW Jackson St., Ste. 420, Topeka, Kansas 66612-1367. Telephone: 785/296-5522. Send one to Water Well Owner and retain one for your records.

7/27/06.

Rosencrantz - Bemis failed to put correct address
on the form WWC-5P. This is to inform you of
the incorrect information. It should be HAVERN HUENERGARDT
^{Virginia}
& Citizens Trust & Beverly Kay.

Thank you

J. O. Huenergardt

8006 E. LEHIGH AVE.

DENVER, COLO. 80237.

303-771-3060

AF1