

WATER WELL RECORD

Form WWC-5


Division of Water Resources App. No.

Blank box for application number

1 LOCATION OF WATER WELL: County: Rush, Fraction: 1/4 SW 1/4 SW 1/4 SW 1/4, Section Number: 5, Township No.: T 18 S, Range Number: R 16, E/W checkboxes

Street/Rural Address of Well Location; if unknown, distance & direction from nearest town or intersection: 4E of Bison, KS. Global Positioning System (GPS) information: Latitude, Longitude, Elevation, Datum, Collection Method

2 WATER WELL OWNER: Carol Bales-Speer, RR#, Street Address, Box #: 2120 CR350, City, State, ZIP Code: Bison, KS 67520

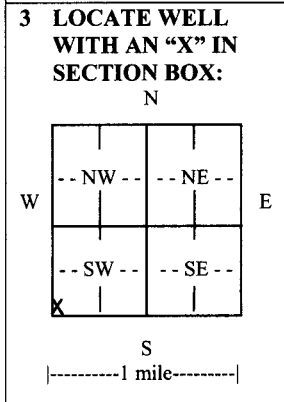

4 DEPTH OF COMPLETED WELL: 103 ft. Depth(s) Groundwater Encountered, WELL'S STATIC WATER LEVEL: 65 ft. below land surface measured on 12/07/10, Pump test data, EST. YIELD: 15 gpm, Bore Hole Diameter, WELL WATER TO BE USED AS: Domestic, Feedlot, Oil field water supply, Dewatering, Other, Irrigation, Industrial, Domestic-lawn & garden, Monitoring well, Was a chemical/bacteriological sample submitted, Water well disinfected?

5 TYPE OF CASING USED: Steel, PVC, Other. CASING JOINTS: Glued, Clamped, Welded, Threaded. Casing diameter: 5 in. to 8.3 ft., Diameter in. to ft., Casing height above land surface: 12 in., Weight: 2.8 lbs./ft., Wall thickness or gauge No. Sch. 40

TYPE OF SCREEN OR PERFORATION MATERIAL: Steel, Stainless Steel, PVC, Brass, Galvanized Steel, None used (open hole). SCREEN OR PERFORATION OPENINGS ARE: Continuous slot, Mill slot, Gauze wrapped, Torch cut, Drilled holes, Louvered shutter, Key punched, Wire wrapped, Saw cut, Other (specify). SCREEN-PERFORATED INTERVALS: From 8.3 ft. to 103 ft., GRAVEL PACK INTERVALS: From 23 ft. to 54 ft., From 59 ft. to 103 ft.

6 GROUT MATERIAL: Neat cement, Cement grout, Bentonite, Other. Grout Intervals: From 0 ft. to 23 ft., From 54 ft. to 59 ft., From ft. to ft. What is the nearest source of possible contamination: Septic tank, Lateral lines, Pit privy, Livestock pens, Insecticide storage, Sewer lines, Cesspool, Sewage lagoon, Fuel storage, Abandoned water well, Watertight sewer lines, Seepage pit, Feedyard, Fertilizer storage, Oil well/gas well, machine shed. Direction from well: West, Distance from well: 58

Table with 6 columns: FROM, TO, LITHOLOGIC LOG, FROM, TO, LITHO. LOG (cont.) or PLUGGING INTERVALS. Rows: 0-2 top soil, 2-48 clay, 48-49 fine sand, 49-75 shale, 75-103 sand rock

7 CONTRACTOR'S OR LANDOWNER'S CERTIFICATION: This water well was constructed, reconstructed, or plugged under my jurisdiction and was completed on (mo/day/year) 12/07/10 and this record is true to the best of my knowledge and belief. Kansas Water Well Contractor's License No. 186. This Water Well Record was completed on (mo/day/year) 12/09/10 under the business name of Kelly's Water Well Service, Inc. by (signature) Kelly's Water Well Service, Inc.

INSTRUCTIONS: Use typewriter or ball point pen. PLEASE PRESS FIRMLY and PRINT clearly. Please fill in blanks and check the correct answers. Send three copies (white, blue, pink) to Kansas Department of Health and Environment, Bureau of Water, Geology Section, 1000 SW Jackson St., Suite 420, Topeka, Kansas 66612-1367. Telephone 785-296-5522. Send one copy to WATER WELL OWNER and retain one for your records. Include fee of \$5.00 for each constructed well. Visit us at http://www.kdheks.gov/waterwell/index.html.