


1	LOCATION OF WATER WELL:	Fraction SW NW SW ¼ ¼ ¼	Section Number 22	Township Number 18	Range Number 16 W E/W
County: Rush					

Distance and direction from nearest town or city street address of well if located within city?

2	WATER WELL OWNER: Roger Kneller RR #, St. Address, Box #: 3631 Hwy 96 City, State, ZIP Code: Albert, KS 67511	Board of Agriculture, Division of Water Resources Application Number: _____
---	--	--

3	MARK WELL'S LOCATION WITH AN "X" IN SECTION BOX:	4 DEPTH OF WELL unknown ft. WELL'S STATIC WATER LEVEL none ft. WELL WAS USED AS: <table style="width:100%; border:none;"> <tr> <td style="width:33%;"><input checked="" type="checkbox"/> 1 Domestic</td> <td style="width:33%;">5 Public Water Supply</td> <td style="width:33%;">9 Dewatering</td> </tr> <tr> <td><input type="checkbox"/> 2 Irrigation</td> <td><input type="checkbox"/> 6 Oil Field Water Supply</td> <td><input type="checkbox"/> 10 Monitoring Well</td> </tr> <tr> <td><input type="checkbox"/> 3 Feedlot</td> <td><input type="checkbox"/> 7 Domestic (Lawn & Garden)</td> <td><input type="checkbox"/> 11 Injection Well</td> </tr> <tr> <td><input type="checkbox"/> 4 Industrial</td> <td><input type="checkbox"/> 8 Air Conditioning</td> <td><input type="checkbox"/> 12 Other</td> </tr>

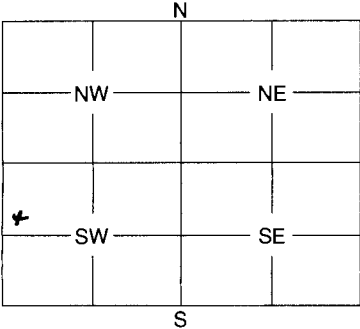

Was a chemical / bacteriological sample submitted to Department? Yes No
 If yes, mo/day/yr sample was submitted

Water Well Disinfected: Yes No

5	TYPE OF BLANK CASING USED:	
<input checked="" type="checkbox"/> 1 Steel	<input type="checkbox"/> 3 RMP (SR)	<input type="checkbox"/> 5 Wrought
<input type="checkbox"/> 2 PVC	<input type="checkbox"/> 4 ABS	<input type="checkbox"/> 6 Asbestos-Cement
		<input type="checkbox"/> 7 Fiberglass
		<input type="checkbox"/> 8 Concrete Tile
		<input type="checkbox"/> 9 Other (Specify below)
Blank casing diameter 5 in.		Was casing pulled? Yes No <input checked="" type="checkbox"/>
Casing height above or below land surface		If yes, how much

6	GROUT PLUG MATERIAL:	<input type="checkbox"/> 1 Neat cement <input checked="" type="checkbox"/> 2 Cement grout <input type="checkbox"/> 3 Bentonite <input type="checkbox"/> 4 Other
Grout Plug Intervals: From 6 ft. to 2 ft., From ft. to ft., From to		
What is the nearest source of possible contamination:		
<input type="checkbox"/> 1 Septic tank	<input type="checkbox"/> 6 Seepage pit	<input type="checkbox"/> 11 Fuel storage
<input type="checkbox"/> 2 Sewer lines	<input type="checkbox"/> 7 Pit privy	<input type="checkbox"/> 12 Fertilizer storage
<input type="checkbox"/> 3 Watertight sewer lines	<input type="checkbox"/> 8 Sewage lagoon	<input type="checkbox"/> 13 Insecticide storage
<input checked="" type="checkbox"/> 4 Lateral lines	<input type="checkbox"/> 9 Feedyard	<input type="checkbox"/> 14 Abandoned water well
<input type="checkbox"/> 5 Cess pool	<input type="checkbox"/> 10 Livestock pens	<input type="checkbox"/> 15 Oil well/Gas well
Direction from well? North		How many feet? 20

FROM	TO	PLUGGING MATERIALS
10	6	gravel (chlorinated)
6	3	cement grout
3	0	silts + clays

7	CONTRACTOR'S OF LANDOWNER'S CERTIFICATION: This water well was plugged under my jurisdiction and was completed on (mo/day/year) 5-16-11 and this record is true to the best of my knowledge and belief. Kansas Water Well Contractor's License No. 751 . This Water Well Record was completed on (mo/day/year) 5-26-11 under the business name of Terra Temp Drilling by (signature) RK Kneller	
---	--	--

INSTRUCTIONS: Use typewriter or ball point pen. Please press firmly and print clearly. Please fill in blanks, underline or circle the correct answers. Send top three copies to Kansas Department of Health and Environment, Bureau of Water, Geology Section, 1000 SW Jackson St., Ste. 420, Topeka, Kansas 66612-1367. Telephone: 785/296-5522. Send one to Water Well Owner and retain one for your records.