


1 LOCATION OF WATER WELL: County: <u>Rush</u>	Fraction <u>SW 1/4 SW 1/4 SE 1/4</u>	Section Number <u>13</u>	Township Number <u>T 18 S</u>	Range Number <u>R 17 EW</u>
--	---	-----------------------------	----------------------------------	--------------------------------

Distance and direction from nearest town or city street address of well if located within city?
1 mile South & 2 1/2 miles East of Timkin, KS

2 WATER WELL OWNER: Tim J. Oborny
 RR#, St. Address, Box #: Rt. 1, Box 70
 City, State, ZIP Code: Bison, KS 67520
 Board of Agriculture, Division of Water Resources
 Application Number: 8963

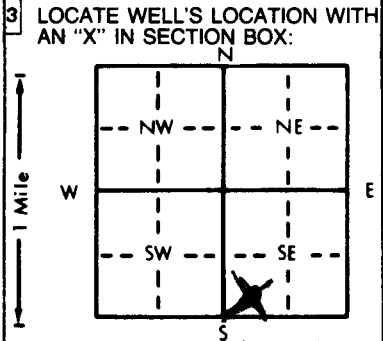

4 DEPTH OF COMPLETED WELL: 58 ft. ELEVATION:

Depth(s) Groundwater Encountered 1. ft. 2. ft. 3. ft.

WELL'S STATIC WATER LEVEL 20 ft. below land surface measured on mo/day/yr 4/29/99

Pump test data: Well water was ft. after hours pumping gpm

Est. Yield 400-500 gpm: Well water was ft. after hours pumping gpm

Bore Hole Diameter: 30 in. to 59 in. to ft.

WELL WATER TO BE USED AS:

5 Public water supply	8 Air conditioning	11 Injection well
1 Domestic	3 Feedlot	6 Oil field water supply
<input checked="" type="checkbox"/> Irrigation	4 Industrial	7 Lawn and garden only
		9 Dewatering
		12 Other (Specify below)
		10 Monitoring well

Was a chemical/bacteriological sample submitted to Department? Yes..... No If yes, mo/day/yr sample was submitted

Water Well Disinfected? Yes No

5 TYPE OF BLANK CASING USED:

1 Steel	3 RMP (SR)	5 Wrought iron	8 Concrete tile	CASING JOINTS: Glued <input checked="" type="checkbox"/> Clamped
<input checked="" type="checkbox"/> PVC	4 ABS	6 Asbestos-Cement	9 Other (specify below)	Welded
		7 Fiberglass		Threaded

Blank casing diameter 1.6 in. to 38 ft., Dia in. to ft., Dia in. to ft.

Casing height above land surface 12 in., weight 16.15 lbs./ft. Wall thickness or gauge No. 500

TYPE OF SCREEN OR PERFORATION MATERIAL:

1 Steel	3 Stainless steel	5 Fiberglass	<input checked="" type="checkbox"/> PVC	10 Asbestos-cement
2 Brass	4 Galvanized steel	6 Concrete tile	8 RMP (SR)	11 Other (specify)
			9 ABS	12 None used (open hole)

SCREEN OR PERFORATION OPENINGS ARE:

1 Continuous slot	<input checked="" type="checkbox"/> Mill slot	5 Gauzed wrapped	8 Saw cut	11 None (open hole)
2 Louvered shutter	4 Key punched	6 Wire wrapped	9 Drilled holes	
		7 Torch cut	10 Other (specify)	

SCREEN-PERFORATED INTERVALS: From 38 ft. to 58 ft., From ft. to ft.

GRAVEL PACK INTERVALS: From 20 ft. to 58 ft., From ft. to ft.

6 GROUT MATERIAL: 1 Neat cement Cement grout 3 Bentonite 4 Other

Grout Intervals: From 0 ft. to 20 ft., From ft. to ft., From ft. to ft.

What is the nearest source of possible contamination:

1 Septic tank	4 Lateral lines	7 Pit privy	<input checked="" type="checkbox"/> Livestock pens	14 Abandoned water well
2 Sewer lines	5 Cess pool	8 Sewage lagoon	11 Fuel storage	15 Oil well/Gas well
3 Watertight sewer lines	6 Seepage pit	9 Feedyard	12 Fertilizer storage	16 Other (specify below)
			13 Insecticide storage	

Direction from well? North How many feet? 800

FROM	TO	LITHOLOGIC LOG	FROM	TO	PLUGGING INTERVALS
0	4	Topsoil			
4	13	Dark Brown Clay			
13	20	Brown Clay			
20	32	Sandy Tan Clay			
32	45	Fine to Coarse Sand with gravel, red			
45	53	Medium to Coarse Sand with brown clay streaks			
53	58	Medium to Coarse Sand with brown limestone rock			
58	59	Green Shale			

7 CONTRACTOR'S OR LANDOWNER'S CERTIFICATION: This water well was (constructed, (2) reconstructed, or (3) plugged under my jurisdiction and was completed on (mo/day/year) 4/30/99 and this record is true to the best of my knowledge and belief. Kansas Water Well Contractor's License No. 138 This Water Well Record was completed on (mo/day/yr) 5/4/99 under the business name of PETERSON IRRIGATION, INC. by (signature) Mike Peterson

OFFICE USE ONLY
T
R
EW
SEC
1/4
1/4
1/4