


1 LOCATION OF WATER WELL: Fraction Section Number Township Number Range Number
 County: Push County NE 1/4 NW 1/4 NW 1/4 15 18 17 E/W
 Distance and direction from nearest town or city street address of well if located within city?

2 WATER WELL OWNER: Edmund Oborny
 RR #, St. Address, Box #: P.O. Box 222 Board of Agriculture, Division of Water Resources
 City, State, ZIP Code: Lalrosse, KS 67548 Application Number:

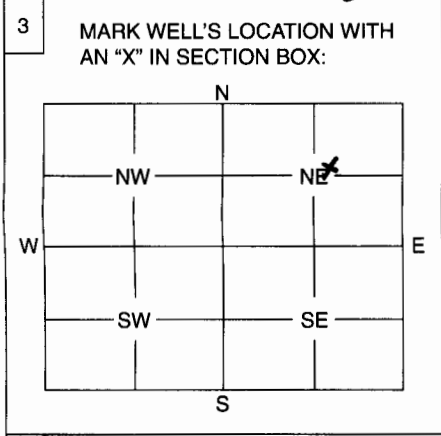

4 DEPTH OF WELL 70' ft.
 WELL'S STATIC WATER LEVEL ft. - No Water
 WELL WAS USED AS:
 Domestic 5 Public Water Supply 9 Dewatering
 Irrigation 6 Oil Field Water Supply 10 Monitoring Well
 Feedlot Domestic (Lawn & Garden) 11 Injection Well
 Industrial 8 Air Conditioning 12 Other
 Was a chemical / bacteriological sample submitted to Department? Yes No Y.....
 If yes, mo/day/yr sample was submitted
 Water Well Disinfected: Yes X No

5 TYPE OF BLANK CASING USED:
 1 Steel 3 RMP (SR) 5 Wrought 7 Fiberglass 9 Other (Specify below)
 2 PVC 4 ABS 6 Asbestos-Cement 8 Concrete Tile
 Blank casing diameter in. Was casing pulled? Yes No If yes, how much 12'
 Casing height above or below land surface 12' in.

6 GROUT PLUG MATERIAL: Neat cement 2 Cement grout 3 Bentonite 4 Other
 Grout Plug Intervals: From 17' ft. to 12' ft., From ft. to ft., From to ft.
 What is the nearest source of possible contamination:
 Septic tank 6 Seepage pit 11 Fuel storage 16 Other (specify below)
 Sewer lines 7 Pit privy 12 Fertilizer storage
 Watertight sewer lines 8 Sewage lagoon 13 Insecticide storage
 Lateral lines 9 Feedyard 14 Abandoned water well
 Cess pool 10 Livestock pens 15 Oil well/Gas well
 Direction from well? South How many feet? 30'

FROM	TO	PLUGGING MATERIALS
70'	60'	Pea Gravel
60'	50'	Compacted clays
50'	17'	Pea Gravel
17'	12'	Cement Plug
12'	0	Casing pulled

7 CONTRACTOR'S OF LANDOWNER'S CERTIFICATION: This water well was plugged under my jurisdiction and was completed on (mo/day/year) 5/15/06 and this record is true to the best of my knowledge and belief. Kansas Water Well Contractor's License No. This Water Well Record was completed on (mo/day/year) under the business name of
 by (signature) X Edmund Oborny

INSTRUCTIONS: Use typewriter or ball point pen. Please press firmly and print clearly. Please fill in blanks, underline or circle the correct answers. Send top three copies to Kansas Department of Health and Environment, Bureau of Water, Geology Section, 1000 SW Jackson St., Ste. 420, Topeka, Kansas 66612-1367. Telephone: 785/296-5522. Send one to Water Well Owner and retain one for your records.