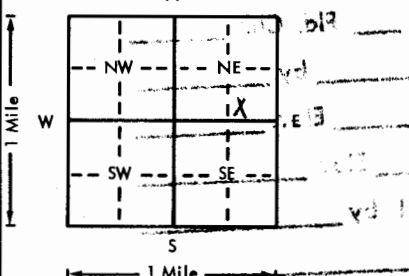


USE TYPEWRITER OR BALL
POINT PEN-PRESS FIRMLY,
PRINT CLEARLY.

WATER WELL RECORD
KSA 82a-1201-1215

Kansas Department of Health and
Environment-Division of Environment
(Water well Contractors)
Topeka, Kansas 66620

1. Location of well:		County <u>Rush</u>	Fraction <u>5 1/2 NE</u> 1/4 1/4 1/4	Section number <u>14</u>	Township number <u>18 S</u>	Range number <u>17 E/W</u>
2. Distance and direction from nearest town or city: <u>1 N 1 E 1/2 N 1/4 W of Timken</u> Street address of well location if in city:			3. Owner of well: <u>Lester Dirks</u> R.R. or street: City, state, zip code: <u>Timken, KS.</u>			
4. Locate with "X" in section below:		Sketch map:		6. Bore hole dia. <u>29</u> in. Completion date <u>7-17-75</u> Well depth <u>81</u> ft.		
				7. Cable tool <input checked="" type="checkbox"/> Rotary <input type="checkbox"/> Driven <input type="checkbox"/> Dug <input type="checkbox"/> Hollow rod <input type="checkbox"/> Jetted <input type="checkbox"/> Bored <input type="checkbox"/> Reverse rotary		
5. Type and color of material		From To		8. Use: <input checked="" type="checkbox"/> Domestic <input type="checkbox"/> Public supply <input type="checkbox"/> Industry <input checked="" type="checkbox"/> Irrigation <input type="checkbox"/> Air conditioning <input type="checkbox"/> Stock <input type="checkbox"/> Lawn <input type="checkbox"/> Oil field water <input type="checkbox"/> Other		
<u>Top Soil</u>		<u>0 3</u>		9. Casing: Material <u>Steel</u> Height: Above or below Threaded <input type="checkbox"/> Welded <input checked="" type="checkbox"/> Surface <u>18</u> in. RMP <input type="checkbox"/> PVC <input type="checkbox"/> Weight <u>16</u> lbs./ft. Dia. <u>16</u> in. to <u>81</u> ft. depth; Wall Thickness: inches or Dia. <u>16</u> in. to <u>81</u> ft. depth; gage No. <u>7</u>		
<u>Brown Clay</u>		<u>3 27</u>		10. Screen: Manufacturer's name <u>Opers</u> Type <u>Steel</u> Dia. <u>16</u> Slot gauge <u>3/16</u> Length <u>28</u> Set between <u>53</u> ft. and <u>81</u> ft. Gravel pack? <input type="checkbox"/> Size range of material <u>1/2 3/4 3/8</u>		
<u>Sand & Gravel</u>		<u>27 46</u>		11. Static water level: <u>25</u> ft. below land surface Date <u>7-10-75</u>		
<u>Clay</u>		<u>46 47</u>		12. Pumping level below land surfaces: <u>25</u> ft. after <u>12</u> hrs. pumping <u>1000</u> g.p.m. ft. after <u>12</u> hrs. pumping <u>1000</u> g.p.m. Estimated maximum yield <u>1200</u> g.p.m.		
<u>Sand & Gravel</u>		<u>47 64</u>		13. Water sample submitted: <u>Yes</u> <input checked="" type="checkbox"/> No <input type="checkbox"/> Date <u>7-16-75</u>		
<u>Clay</u>		<u>64 65</u>		14. Well head completion: <input type="checkbox"/> Pitless adapter <input type="checkbox"/> Inches above grade		
<u>Sand & Gravel</u>		<u>65 67</u>		15. Well grouted? <input checked="" type="checkbox"/> With: <input type="checkbox"/> Neat cement <input type="checkbox"/> Bentonite <input checked="" type="checkbox"/> Concrete Depth: From <u>0</u> ft. to <u>10</u> ft.		
<u>Clay Green</u>		<u>67 68</u>		16. Nearest source of possible contamination: ft. <u>112</u> Direction <u>N</u> Type <u>correl</u> Well disinfected upon completion? <u>HTH</u> Yes <input checked="" type="checkbox"/> No <input type="checkbox"/>		
<u>Sand & Gravel</u>		<u>68 76</u>		17. Pump: <input type="checkbox"/> Not installed Manufacturer's name <u>WLR</u> Model number <u>2-BK-12</u> HP <u>30</u> Volts <u>1000</u> Length of drop pipe <u>75</u> ft. capacity <u>1000</u> g.p.m. Type: <input type="checkbox"/> Submersible <input checked="" type="checkbox"/> Turbine <input type="checkbox"/> Jet <input type="checkbox"/> Reciprocating <input type="checkbox"/> Centrifugal <input type="checkbox"/> Other		
<u>Yellow Clay</u>		<u>76 77</u>		20. Water well contractor's certification: This well was drilled under my jurisdiction and this report is true to the best of my knowledge and belief. <u>Rosenkrantz-Bemis</u> 134 Business name License No. Address <u>Great Bend, KS.</u> Signed <u>Frederic Rodman</u> Date <u>7/24/75</u> Authorized representative		
<u>Sand & Gravel</u>		<u>77 81</u>				
<u>Blue. Shale</u>		<u>81</u>				
18. Elevation:		19. Remarks:				
Topography: <input type="checkbox"/> Hill <input type="checkbox"/> Slope <input checked="" type="checkbox"/> Upland <input type="checkbox"/> Valley		<u>1961</u> <u>81</u> <u>1500</u>				

Forward the white, blue and pink copies to the Department of Health and Environment

Form WWC-5