


LOCATION OF WATER WELL: Fraction SE  $\frac{1}{4}$  SE  $\frac{1}{4}$  NE  $\frac{1}{4}$  Section Number 34 Township Number T 18 S Range Number R 17W E/W  
 County: Rush

Distance and direction from nearest town or city street address of well if located within city?  
1 1/2 S of Timken, Kansas

WATER WELL OWNER: Larry Stejskal  
 RR#, St. Address, Box # : Route 1  
 City, State, ZIP Code : Timken, Ks. 67582  
 Board of Agriculture, Division of Water Resources  
 Application Number: None

LOCATE WELL'S LOCATION WITH AN "X" IN SECTION BOX: 4 DEPTH OF COMPLETED WELL... 163 ft. ELEVATION: Unknown

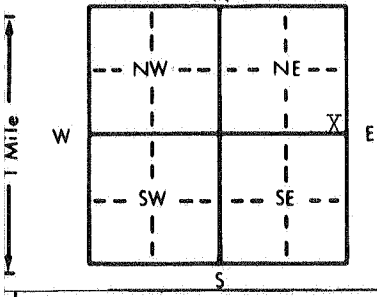

Depth(s) Groundwater Encountered 1. 105 ft. 2. .... ft. 3. .... ft.  
 WELL'S STATIC WATER LEVEL ... 105 ft. below land surface measured on mo/day/yr ... 4/24/86  
 Pump test data: Well water was ... ft. after ... hours pumping ... gpm  
 Est. Yield ... 60 gpm: Well water was ... ft. after ... hours pumping ... gpm  
 Bore Hole Diameter ... 8 in. to 163 ft., and ... in. to ... ft.  
 WELL WATER TO BE USED AS: 5 Public water supply 8 Air conditioning 11 Injection well  
 1 Domestic 3 Feedlot 6 Oil field water supply 9 Dewatering 12 Other (Specify below)  
 2 Irrigation 4 Industrial 7 Lawn and garden only 10 Observation well  
 Was a chemical/bacteriological sample submitted to Department? Yes... No...; If yes, mo/day/yr sample was submitted  
 Water Well Disinfected? Yes X 16

TYPE OF BLANK CASING USED: 5 Wrought iron 8 Concrete tile CASING JOINTS: Glued ... Clamped ...  
 1 Steel 3 RMP (SR) 6 Asbestos-Cement 9 Other (specify below) Welded ...  
 2 PVC 4 ABS 7 Fiberglass ... Threaded ...

Blank casing diameter ... 5 in. to 143 ft., Dia ... in. to ... ft., Dia ... in. to ... ft.  
 Casing height above land surface ... 12 in., weight ... 2.8 lbs./ft. Wall thickness or gauge No. ... Sch. 40

TYPE OF SCREEN OR PERFORATION MATERIAL: 7 PVC 10 Asbestos-cement  
 1 Steel 3 Stainless steel 5 Fiberglass 8 RMP (SR) 11 Other (specify) ...  
 2 Brass 4 Galvanized steel 6 Concrete tile 9 ABS 12 None used (open hole)

SCREEN OR PERFORATION OPENINGS ARE: 5 Gauzed wrapped 8 Saw cut 11 None (open hole)  
 1 Continuous slot 3 Mill slot 6 Wire wrapped 9 Drilled holes  
 2 Louvered shutter 4 Key punched 7 Torch cut 10 Other (specify) ...

SCREEN-PERFORATED INTERVALS: From ... 143 ft. to ... 163 ft., From ... ft. to ... ft.  
 GRAVEL PACK INTERVALS: From ... 10 ft. to ... 163 ft., From ... ft. to ... ft.

GROUT MATERIAL: 1 Neat cement 2 Cement grout 3 Bentonite 4 Other ...  
 Grout Intervals: From ... 0 ft. to 10 ft., From ... ft. to ... ft., From ... ft. to ... ft.

What is the nearest source of possible contamination: 10 Livestock pens 14 Abandoned water well  
 1 Septic tank 4 Lateral lines 7 Pit privy 11 Fuel storage 15 Oil well/Gas well  
 2 Sewer lines 5 Cess pool 8 Sewage lagoon 12 Fertilizer storage 16 Other (specify below)  
 3 Watertight sewer lines 6 Seepage pit 9 Feedyard 13 Insecticide storage Middle of pasture

Direction from well? How many feet?

FROM	TO	LITHOLOGIC LOG	FROM	TO	LITHOLOGIC LOG
0	10	Clay			
10	125	Shale			
125	163	Sand rock			

CONTRACTOR'S OR LANDOWNER'S CERTIFICATION: This water well was (1) constructed, (2) reconstructed, or (3) plugged under my jurisdiction and was completed on (mo/day/year) 4/24/86 and this record is true to the best of my knowledge and belief. Kansas Water Well Contractor's License No. ... 186 This Water Well Record was completed on (mo/day/yr) ... 6/8/86 under the business name of Kelly's Water Well Service by (signature) [Signature]

INSTRUCTIONS: Use typewriter or ball point pen. PLEASE PRESS FIRMLY and PRINT clearly. Please fill in blanks, underline or circle the correct answers. Send top three copies to Kansas Department of Health and Environment, Office of Oil Field and Environmental Geology, Regulation and Permitting Section, Topeka, Kansas 66620-7500, Telephone: 913-862-9360. Send one to WATER WELL OWNER and retain one for your records.