


1 LOCATION OF WATER WELL:	Fraction	Section Number	Township Number	Range Number
County: Rush	SW 1/4 NE 1/4 SE 1/4	4	T 18 S	R 17 R W

Distance and direction from nearest town or city street address of well if located within city?
 Approximately 1/4 mile southwest of Bison

2 WATER WELL OWNER: Bison, City of
 RR#, St. Address, Box #: City Hall - 218 Main St.
 City, State, ZIP Code: Bison, KS 67520

Board of Agriculture, Division of Water Resources
 Application Number: 12016 & RH 0004

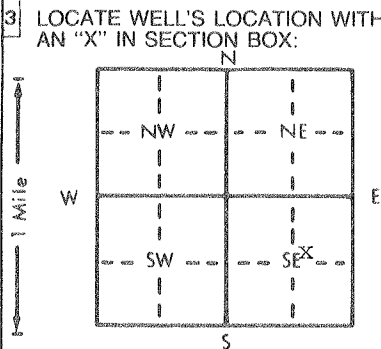

4 DEPTH OF COMPLETED WELL: 73 ft. ELEVATION: unknown

Depth(s) Groundwater Encountered 1. ft. 2. ft. 3. ft.

WELL'S STATIC WATER LEVEL . . . 15 ft. below land surface measured on mo/day/yr 12-22-94

Pump test data: Well water was not ch'd ft. after hours pumping gpm

Est. Yield unknown gpm: Well water was ft. after hours pumping gpm

Bore Hole Diameter . . 30 in. to 72 ft., and in. to ft.

WELL WATER TO BE USED AS: 5 Public water supply 8 Air conditioning 11 Injection well
 1 Domestic 3 Feedlot 6 Oil field water supply 9 Dewatering 12 Other (Specify below)
 2 Irrigation 4 Industrial 7 Lawn and garden only 10 Monitoring well

Was a chemical/bacteriological sample submitted to Department? Yes......No.....; If yes, mo/day/yr sample was submitted 8-10-94 Water Well Disinfected? Yes No

5 TYPE OF BLANK CASING USED:

1 Steel	3 RMP (SR)	5 Wrought iron	8 Concrete tile	CASING JOINTS: Glued Clamped
2 PVC	4 ABS	6 Asbestos-Cement	9 Other (specify below)	Welded . . . <input checked="" type="checkbox"/>
		7 Fiberglass		Threaded

Blank casing diameter . . 12 3/4 in. to 62 ft., Dia in. to ft., Dia in. to ft.

Casing height above land surface 24 in., weight 49.56 lbs./ft. Wall thickness or gauge No. . . . 375

TYPE OF SCREEN OR PERFORATION MATERIAL:

1 Steel	3 Stainless steel	5 Fiberglass	8 RMP (SR)	10 Asbestos-cement
2 Brass	4 Galvanized steel	6 Concrete tile	9 ABS	11 Other (specify)
				12 None used (open hole)

SCREEN OR PERFORATION OPENINGS ARE:

1 Continuous slot	3 Mill slot	5 Gauzed wrapped	8 Saw cut	11 None (open hole)
2 Louvered shutter	4 Key punched	6 Wire wrapped	9 Drilled holes	
		7 Torch cut	10 Other (specify)	

SCREEN-PERFORATED INTERVALS: From 62 ft. to 71 ft., From ft. to ft.

GRAVEL PACK INTERVALS: From 49 ft. to 72 ft., From ft. to ft.

6 GROUT MATERIAL: 1 Neat cement 2 Cement grout 3 Bentonite 4 Other Bentonite Holeplug

Grout Intervals: From ^{Topsoil} 0 ft. to 5 ft., From 5 ft. to 44 ft., From 44 ft. to 49 ft.

What is the nearest source of possible contamination:

1 Septic tank	4 Lateral lines	7 Pit privy	10 Livestock pens	14 Abandoned water well
2 Sewer lines	5 Cess pool	8 Sewage lagoon	11 Fuel storage	15 Oil well/Gas well
3 Watertight sewer lines	6 Seepage pit	9 Feedyard	12 Fertilizer storage	16 Other (specify below)
			13 Insecticide storage	None known

Direction from well? How many feet?

FROM	TO	LITHOLOGIC LOG	FROM	TO	PLUGGING INTERVALS
0	4	Topsoil			
4	29	Clay, brown			
29	36	Clay, dark brown			
36	46	Sand and limestone pieces, fine, medium			
46	51	Clay, brown			
51	61	Clay, light brown, sticky			
61	71	Sand and gravel, fine, medium, with limestone pieces			
71	72	Sand and gravel, medium, with limestone and clay			
72		Shale, black			

7 CONTRACTOR'S OR LANDOWNER'S CERTIFICATION: This water well was (1) constructed, (2) reconstructed, or (3) plugged under my jurisdiction and was completed on (mo/day/year) 12-22-94 and this record is true to the best of my knowledge and belief. Kansas Water Well Contractor's License No. 185 This Water Well Record was completed on (mo/day/yr) 1-10-95 under the business name of Clarke Well & Equipment, Inc. by (signature) *Clarke Well & Equipment*

INSTRUCTIONS: Use typewriter or ball point pen. PLEASE PRESS FIRMLY and PRINT clearly. Please fill in blanks, underline or circle the correct answers. Send top three copies to Kansas Department of Health and Environment, Bureau of Water, Topeka, Kansas 66620-0001. Telephone: 913-296-5545. Send one to WATER WELL OWNER and retain one for your records.