


1 LOCATION OF WATER WELL: Fraction Section Number Township Number Range Number  
 County: Rush SE 1/4 NE 1/4 SE 1/4 32 T 18 S R 17 EW

Distance and direction from nearest town or city street address of well if located within city?  
 2 miles west, 2 miles south of Timken, Kansas

2 WATER WELL OWNER: Ed Tomecek  
 RR#, St. Address, Box # : Board of Agriculture, Division of Water Resources  
 City, State, ZIP Code : Timken, Kansas 67582 Application Number:

3 LOCATE WELL'S LOCATION WITH AN "X" IN SECTION BOX: 4 DEPTH OF COMPLETED WELL: 285 ft. ELEVATION: Upland  
 Depth(s) Groundwater Encountered 1. 116 ft. 2. ft. 3. ft.  
 WELL'S STATIC WATER LEVEL . 85 ft. below land surface measured on mo/day/yr . 5/24/95  
 Pump test data: Well water was . 84 ft. after . 1 hours pumping . 40 gpm  
 Est. Yield . 40 gpm: Well water was . ft. after . hours pumping . gpm  
 Bore Hole Diameter . 5 in. to . 285 ft., and . in. to . ft.  
 WELL WATER TO BE USED AS: 1 5 Public water supply 8 Air conditioning 11 Injection well  
 1 Domestic 3 Feedlot 6 Oil field water supply 9 Dewatering 12 Other (Specify below)  
 2 Irrigation 4 Industrial 7 Lawn and garden only 10 Monitoring well  
 Was a chemical/bacteriological sample submitted to Department? Yes.....No...X...; If yes, mo/day/yr sample was submitted  
 Water Well Disinfected? Yes X No

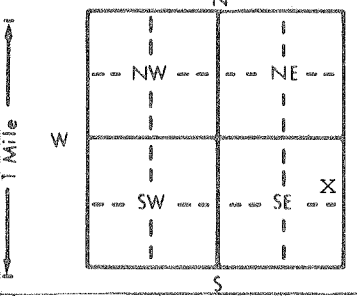

5 TYPE OF BLANK CASING USED: 2 5 Wrought iron 8 Concrete tile CASING JOINTS: Glued X Clamped  
 1 Steel 3 RMP (SR) 6 Asbestos-Cement 9 Other (specify below) Welded  
 2 PVC 4 ABS 7 Fiberglass Threaded  
 Blank casing diameter . 5 in. to . 245 ft., Dia . in. to . ft., Dia . in. to . ft.  
 Casing height above land surface . 24 in., weight . 2.29 lbs./ft. Wall thickness or gauge No. . 26  
 TYPE OF SCREEN OR PERFORATION MATERIAL: 7 7 PVC 10 Asbestos-cement  
 1 Steel 3 Stainless steel 5 Fiberglass 8 RMP (SR) 11 Other (specify)  
 2 Brass 4 Galvanized steel 6 Concrete tile 9 ABS 12 None used (open hole)  
 SCREEN OR PERFORATION OPENINGS ARE: 8 5 Gauzed wrapped 8 Saw cut 11 None (open hole)  
 1 Continuous slot 3 Mill slot 6 Wire wrapped 9 Drilled holes  
 2 Louvered shutter 4 Key punched 7 Torch cut 10 Other (specify)  
 SCREEN-PERFORATED INTERVALS: From . 285 ft. to . 245 ft., From . ft. to . ft.  
 From . ft. to . ft., From . ft. to . ft.  
 GRAVEL PACK INTERVALS: From . 285 ft. to . 20 ft., From . ft. to . ft.  
 From . ft. to . ft., From . ft. to . ft.

6 GROUT MATERIAL: 3 1 Neat cement 2 Cement grout 3 Bentonite 4 Other  
 Grout intervals: From . 0 ft. to . 20 ft., From . ft. to . ft., From . ft. to . ft.  
 What is the nearest source of possible contamination: None  
 1 Septic tank 4 Lateral lines 7 Pit privy 10 Livestock pens 14 Abandoned water well  
 2 Sewer lines 5 Cess pool 8 Sewage lagoon 11 Fuel storage 15 Oil well/Gas well  
 3 Watertight sewer lines 6 Seepage pit 9 Feedyard 12 Fertilizer storage 16 Other (specify below)  
 13 Insecticide storage

Direction from well? How many feet?

FROM	TO	LITHOLOGIC LOG	FROM	TO	PLUGGING INTERVALS
0	2	Topsoil			
2	8	Gumbo			
8	28	Clay			
28	88	Shale			
88	100	Hard, white rock			
100	116	Dakota clay, white rock mix			
116	145	White, sandy clay			
145	170	Red clay			
170	190	Small, sandrock layers			
190	220	Red clay			
220	232	Small sandrock layers			
232	250	Red clay			
250	265	Sandrock and clay			
265	285	Sandrock			

7 CONTRACTOR'S OR LANDOWNER'S CERTIFICATION: This water well was (1) constructed, (2) reconstructed, or (3) plugged under my jurisdiction and was completed on (mo/day/year) . 5/24/95 and this record is true to the best of my knowledge and belief. Kansas Water Well Contractor's License No. . 199 This Water Well Record was completed on (mo/day/yr) . 5/26/95 under the business name of Karst Water Well Drilling & Service, Inc. by (signature)

INSTRUCTIONS: Use typewriter or ball point pen. PLEASE PRESS FIRMLY and PRINT clearly. Please fill in blanks, underline or circle the correct answers. Send top three copies to Kansas Department of Health and Environment, Bureau of Water, Topeka, Kansas 66620-0001. Telephone: 913-296-5545. Send one to WATER WELL OWNER and retain one for your records.