


1 LOCATION OF WATER WELL: Fraction NE 1/4 NE 1/4 NE 1/4 Section Number 28 Township Number T 18 S Range Number R 18 E  
 County: Rush

Distance and direction from nearest town or city street address of well if located within city?  
Hwy. 183 & Hwy. 96 Int. Rush Center, KS.

2 WATER WELL OWNER: Renzoil  
 RR#, St. Address, Box # : Hwy 183 & 96 Board of Agriculture, Division of Water Resources  
 City, State, ZIP Code : Rush Center, Ks. Application Number:

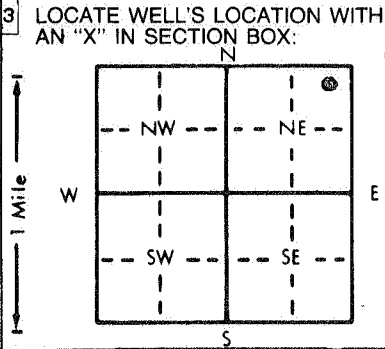

4 DEPTH OF COMPLETED WELL 65' ft. ELEVATION: ..... ft.  
 Depth(s) Groundwater Encountered 1. 25' ft. 2. .... ft. 3. .... ft.  
 WELL'S STATIC WATER LEVEL 18.30 ft. below land surface measured on mo/day/yr 4-5-96  
 Pump test data: Well water was ..... ft. after ..... hours pumping ..... gpm  
 Est. Yield ..... gpm; Well water was ..... ft. after ..... hours pumping ..... gpm  
 Bore Hole Diameter: 14" in. to 65' ft., and ..... in. to ..... ft.  
 WELL WATER TO BE USED AS: 5 Public water supply 8 Air conditioning 11 Injection well Soil Remediation  
 1 Domestic 3 Feedlot 6 Oil field water supply 9 Dewatering 12 Other (Specify below)  
 2 Irrigation 4 Industrial 7 Lawn and garden only 10 Monitoring well  
 Was a chemical/bacteriological sample submitted to Department? Yes.....No X; If yes, mo/day/yr sample was submitted  
 Water Well Disinfected? Yes No

5 TYPE OF BLANK CASING USED: 5 Wrought iron 8 Concrete tile CASING JOINTS: Glued ..... Clamped .....  
 1 Steel 3 RMP (SR) 6 Asbestos-Cement 9 Other (specify below) Welded .....  
2 PVC 4 ABS 7 Fiberglass ..... Threaded X  
 Blank casing diameter 6.50 in. to 20' ft., Dia ..... in. to ..... ft., Dia ..... in. to SDR 13 ft.  
 Casing height above land surface 1' in., weight ..... lbs./ft. Wall thickness or gauge No. SCH 40  
 TYPE OF SCREEN OR PERFORATION MATERIAL: 7 PVC 10 Asbestos-cement  
 1 Steel 3 Stainless steel 5 Fiberglass 8 RMP (SR) 11 Other (specify) .....  
 2 Brass 4 Galvanized steel 6 Concrete tile 9 ABS 12 None used (open hole)  
 SCREEN OR PERFORATION OPENINGS ARE: 5 Gauzed wrapped 8 Saw cut 11 None (open hole)  
 1 Continuous slot 3 Mill slot 6 Wire wrapped 9 Drilled holes  
 2 Louvered shutter 4 Key punched 7 Torch cut 10 Other (specify) .....  
 SCREEN-PERFORATED INTERVALS: From 65' ft. to 20' ft., From ..... ft. to ..... ft.  
 From ..... ft. to ..... ft., From ..... ft. to ..... ft.  
 GRAVEL PACK INTERVALS: From 65' ft. to 18' ft., From ..... ft. to ..... ft.  
 From ..... ft. to ..... ft., From ..... ft. to ..... ft.

6 GROUT MATERIAL: 1 Neat cement 2 Cement grout 3 Bentonite 4 Other .....  
 Grout Intervals: From 18' ft. to 16' ft., From 16' ft. to 4' ft., From ..... ft. to ..... ft.  
 What is the nearest source of possible contamination: 10 Livestock pens 14 Abandoned water well  
 1 Septic tank 4 Lateral lines 7 Pit privy 11 Fuel storage 15 Oil well/Gas well  
 2 Sewer lines 5 Cess pool 8 Sewage lagoon 12 Fertilizer storage 16 Other (specify below)  
 3 Watertight sewer lines 6 Seepage pit 9 Feedyard 13 Insecticide storage  
 Direction from well? Northwest How many feet? 380'

FROM	TO	LITHOLOGIC LOG	FROM	TO	PLUGGING INTERVALS
0	2	Dk brn clay w/ ls.rx. gravel, dry to moist.			
2	7.50	Med brn clay to silty clay w/ ls.rx. gravel & caliche, moist, earthy odor.			
7.50	12	Med brn clay, stiff-firm, no odor.			
12	15.75	Med brn clayey silt, soft, moist-wet, no odor.			
15.75	20	Dk brn clay, firm, tight, no odor.			
20	27.25	Gray silty-sandy silt to silty sand, wet, soft, no odor, fine grained sand.			
27.25	35	Gray sand & gravel, wet, no odor, poorly sorted.			
35	58.50	Fine-very coarse grained gravelly sand, wet, no odor, poorly sorted, subrounded grains of qtz, ls, feldspar.			
58.50	65	Yellow brn sandy clay to clayey sand, wet soft, highly plastic, fine-very coarse w. few pebbles.			

7 CONTRACTOR'S OR LANDOWNER'S CERTIFICATION: This water well was (1) constructed (2) reconstructed, or (3) plugged under my jurisdiction and was completed on (mo/day/year) 3-18-96 and this record is true to the best of my knowledge and belief. Kansas Water Well Contractor's License No. 539 This Water Well Record was completed on (mo/day/yr) 5-18-96 under the business name of JB Environmental Drilling by (signature) James Bieber