


1 LOCATION OF WATER WELL: County: Rush Fraction SW 1/4 NW 1/4 SW 1/4 Section Number 25 Township Number T 18 S Range Number R 18 ~~NE~~W

Distance and direction from nearest town or city street address of well if located within city?  
 1/2 south, 1 3/4 east of Rush Center, Ks.

2 WATER WELL OWNER: T.D. Baron  
 RR#, St. Address, Box #: Rush Center, Ks. 67548 Board of Agriculture, Division of Water Resources  
 City, State, ZIP Code: Application Number:

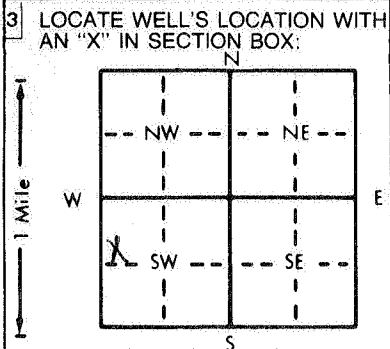

4 DEPTH OF COMPLETED WELL: 54 ft. ELEVATION:  
 Depth(s) Groundwater Encountered 1. ft. 2. ft. 3. ft.  
 WELL'S STATIC WATER LEVEL: 26 ft. below land surface measured on mo/day/yr 7-23-96  
 Pump test data: Well water was ft. after hours pumping gpm  
 Est. Yield gpm: Well water was ft. after hours pumping gpm  
 Bore Hole Diameter: WAS in. to ft., and in. to ft.  
 WELL WATER TO BE USED AS:  
 1 Domestic 2 Irrigation 3 Feedlot 4 Industrial 5 Public water supply 6 Oil field water supply 7 Lawn and garden only 8 Air conditioning 9 Dewatering 10 Monitoring well 11 Injection well 12 Other (Specify below)  
 Was a chemical/bacteriological sample submitted to Department? Yes No: If yes, mo/day/yr sample was submitted Water Well Disinfected? Yes No

5 TYPE OF CASING USED:  
 1 Steel 2 PVC 3 RMP (SR) 4 ABS 5 Wrought iron 6 Asbestos-Cement 7 Fiberglass 8 Concrete tile 9 Other (specify below)  
 CASING JOINTS: Glued Clamped Welded Threaded  
 Blank casing diameter 16 in. to ft., Dia in. to ft.  
 Casing height above/below land surface 3' in., weight lbs./ft. Wall thickness or gauge No.  
 TYPE OF SCREEN OR PERFORATION MATERIAL:  
 1 Steel 2 Brass 3 Stainless steel 4 Galvanized steel 5 Fiberglass 6 Concrete tile 7 PVC 8 RMP (SR) 9 ABS 10 Asbestos-cement 11 Other (specify) 12 None used (open hole)  
 SCREEN OR PERFORATION OPENINGS ARE:  
 1 Continuous slot 2 Louvered shutter 3 Mill slot 4 Key punched 5 Gauzed wrapped 6 Wire wrapped 7 Torch cut 8 Saw cut 9 Drilled holes 11 None (open hole) 12 Other (specify)  
 SCREEN-PERFORATED INTERVALS: From ft. to ft., From ft. to ft.  
 GRAVEL PACK INTERVALS: From ft. to ft., From ft. to ft.

6 GROUT MATERIAL: 1 Neat cement 2 Cement grout 3 Bentonite 4 Other  
 Grout Intervals: From 3 ft. to 27 ft., From ft. to ft., From ft. to ft.  
 What is the nearest source of possible contamination:  
 1 Septic tank 2 Sewer lines 3 Watertight sewer lines 4 Lateral lines 5 Cess pool 6 Seepage pit 7 Pit privy 8 Sewage lagoon 9 Feedyard 10 Livestock pens 11 Fuel storage 12 Fertilizer storage 13 Insecticide storage 14 Abandoned water well 15 Oil well/Gas well 16 Other (specify below)  
 Direction from well? How many feet?

FROM	TO	LITHOLOGIC LOG	FROM	TO	PLUGGING INTERVALS
		54 ft. to 27 sand and gravel 27 ft, to 3' below ground cement cut casing off 3' below ground			

7 CONTRACTOR'S OR LANDOWNER'S CERTIFICATION: This water well was (1) constructed, (2) reconstructed, or (3) plugged under my jurisdiction and was completed on (mo/day/year) 7-31-96 and this record is true to the best of my knowledge and belief. Kansas Water Well Contractor's License No. 134 This Water Well Record was completed on (mo/day/yr) 8-21-96 under the business name of Rosenkrantz- BEmis by (signature) Fredia Barton

INSTRUCTIONS: Use typewriter or ball point pen. PLEASE PRESS FIRMLY and PRINT clearly. Please fill in blanks, underline or circle the correct answers. Send top three copies to Kansas Department of Health and Environment, Bureau of Water, Topeka, Kansas 66620-0001. Telephone: 913-296-5545. Send one to WATER WELL OWNER and retain one for your records.