


1] LOCATION OF WATER WELL: Fraction Section Number Township Number Range Number
County: Rush SE 1/4 NE 1/4 NW 1/4 34 T 18 S R 18w E/W

Distance and direction from nearest town or city street address of well if located within city?
1S of Rush Center, Ks.

2] WATER WELL OWNER: William Melton
RR#, St. Address, Box #: RR 1, Box 87
City, State, ZIP Code: Rush Center, Ks. 67575
Board of Agriculture, Division of Water Resources
Application Number:

3] LOCATE WELL'S LOCATION WITH AN "X" IN SECTION BOX:
4] DEPTH OF COMPLETED WELL: 55 ft. ELEVATION: unknown
Depth(s) Groundwater Encountered: 1... 22 ft. 2... ft. 3... ft.
WELL'S STATIC WATER LEVEL: 22 ft. below land surface measured on mo/day/yr 11/30/00
Pump test data: Well water was ... ft. after ... hours pumping ... gpm
Est. Yield ... gpm: Well water was ... ft. after ... hours pumping ... gpm
Bore Hole Diameter ... in. to ... ft., and ... in. to ... ft.
WELL WATER TO BE USED AS: 5 Public water supply 8 Air conditioning 11 Injection well
1 Domestic 3 Feedlot 6 Oil field water supply 9 Dewatering 12 Other (Specify below)
2 Irrigation 4 Industrial 7 Domestic (lawn & garden) 10 Monitoring well
Was a chemical/bacteriological sample submitted to Department? Yes. No. ; If yes, mo/day/yrs sample was submitted
Water Well Disinfected? Yes No

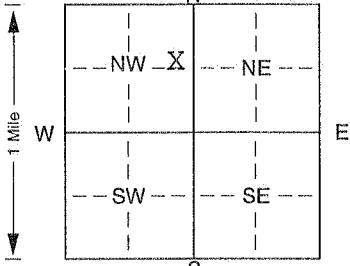

5] TYPE OF BLANK CASING USED: 5 Wrought iron 8 Concrete tile CASING JOINTS: Glued. Clamped.
1 Steel 3 RMP (SR) 6 Asbestos-Cement 9 Other (specify below) Welded
2 PVC 4 ABS 7 Fiberglass Threaded
Blank casing diameter: 16 in. to ... ft., Dia ... in. to ... ft., Dia ... in. to ... ft.
Casing height above land surface: 3 ft. below in., weight ... lbs./ft. Wall thickness or gauge No.
TYPE OF SCREEN OR PERFORATION MATERIAL: 7 PVC 10 Asbestos-cement
1 Steel 3 Stainless steel 5 Fiberglass 8 RMP (SR) 11 Other (specify)
2 Brass 4 Galvanized steel 6 Concrete tile 9 ABS 12 None used (open hole)
SCREEN OR PERFORATION OPENINGS ARE: 5 Gauzed wrapped 8 Saw cut 11 None (open hole)
1 Continuous slot 3 Mill slot 6 Wire wrapped 9 Drilled holes
2 Louvered shutter 4 Key punched 7 Torch cut 10 Other (specify) N/A
SCREEN-PERFORATED INTERVALS: From ... ft. to ... ft., From ... ft. to ... ft.
GRAVEL PACK INTERVALS: From ... ft. to ... ft., From ... ft. to ... ft.

6] GROUT MATERIAL: 1 Neat cement 2 Cement grout 3 Bentonite 4 Other
Grout Intervals: From ... 3 ft. to ... 22 ft., From ... ft. to ... ft.
What is the nearest source of possible contamination: 10 Livestock pens 14 Abandoned water well
1 Septic tank 4 Lateral lines 7 Pit privy 11 Fuel storage 15 Oil well/Gas well
2 Sewer lines 5 Cess pool 8 Sewage lagoon 12 Fertilizer storage 16 Other (specify below)
3 Watertight sewer lines 6 Seepage pit 9 Feedyard 13 Insecticide storage
Direction from well? How many feet?

Table with columns: FROM, TO, LITHOLOGIC LOG, FROM, TO, PLUGGING INTERVALS. Rows show data for 55-22, 22-3, and 3-0 depths.

7] CONTRACTOR'S OR LANDOWNER'S CERTIFICATION: This water well was (1) constructed, (2) reconstructed, or (3) plugged under my jurisdiction and was completed on (mo/day/year) 11/30/00 and this record is true to the best of my knowledge and belief. Kansas Water Well Contractor's Licence No. 186 This Water Well Record was completed on (mo/day/yr) 12/6/00 under the business name of Kelly's Water Well Service, Inc. by (signature) Kathryn L Good

INSTRUCTIONS: Use typewriter or ball point pen. PLEASE PRESS FIRMLY and PRINT clearly. Please fill in blanks, underline or circle the correct answers. Send top three copies to Kansas Department of Health and Environment, Bureau of Water, Topeka, Kansas 66620-0001. Telephone 785-296-5524. Send one to WATER WELL OWNER and retain one for your records. Fee of \$5.00 for each constructed well.