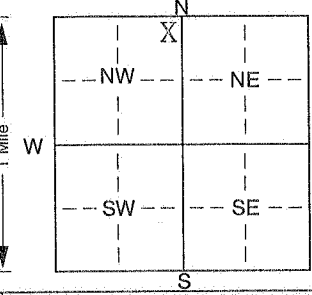


KSA 82a-1212 ID No.

LOCATION OF WATER WELL:		Fraction	Section Number		Township Number		Range Number	
County: Rush	NE 1/4	NE 1/4	NW 1/4	30	T 18	S	R 18	EW
Distance and direction from nearest town or city street address of well if located within city?								
1 3/4 west of Rush Center, KS								
WATER WELL OWNER: Jim Anschutz					Board of Agriculture, Division of Water Resources			
RRR#, St. Address, Box #: 4110 Falcon					Application Number: #148			
City, State, ZIP Code: Great Bend, KS 67530								
LOCATE WELL'S LOCATION WITH AN "X" IN SECTION BOX:		DEPTH OF COMPLETED WELL: 65 ft. ELEVATION:						
		Depth(s) Groundwater Encountered 1. 65 ft. 2. ft. 3. ft.						
		WELL'S STATIC WATER LEVEL: 27.6 ft. below land surface measured on mo/day/yr 6-6-02						
		Pump test data: Well water was 42 ft. after 1 1/2 hours pumping 900 gpm						
		Est. Yield 1000 gpm: Well water was 45 ft. after 2 hours pumping 1000 gpm						
		Bore Hole Diameter: 28 in. to 65 ft., and in. to ft.						
		WELL WATER TO BE USED AS: 5 Public water supply 8 Air conditioning 11 Injection well						
		1 Domestic 3 Feedlot 6 Oil field water supply 9 Dewatering 12 Other (Specify below)						
		2 Irrigation 4 Industrial 7 Domestic (lawn & garden) 10 Monitoring well						
		Was a chemical/bacteriological sample submitted to Department? Yes. No. X; If yes, mo/day/yr sample was submitted						
		Water Well Disinfected? Yes No X						
TYPE OF BLANK CASING USED:		CASING JOINTS: Glued. X Clamped.						
1 Steel 3 RMP (SR) 6 Asbestos-Cement 9 Other (specify below) Welded								
2 PVC 4 ABS 7 Fiberglass Threaded								
Blank casing diameter 16 in. to 45 ft., Dia in. to ft., Dia in. to ft.								
Casing height above land surface 12 in., weight sch 40 lbs./ft. Wall thickness or gauge No.								
TYPE OF SCREEN OR PERFORATION MATERIAL:		7 PVC 10 Asbestos-cement						
1 Steel 3 Stainless steel 5 Fiberglass 8 RMP (SR) 11 Other (specify)								
2 Brass 4 Galvanized steel 6 Concrete tile 9 ABS 12 None used (open hole)								
SCREEN OR PERFORATION OPENINGS ARE:		5 Gauzed wrapped 8 Saw cut 11 None (open hole)						
1 Continuous slot 3 Mill slot 6 Wire wrapped 9 Drilled holes								
2 Louvered shutter 4 Key punched 7 Torch cut 10 Other (specify) ft.								
SCREEN-PERFORATED INTERVALS: From 45 ft. to 65 ft., From ft. to ft.								
GRAVEL PACK INTERVALS: From 65 ft. to 20 ft., From ft. to ft.								
From ft. to ft., From ft. to ft.								
6 GROUT MATERIAL: 1 Neat cement 2 Cement grout 3 Bentonite 4 Other								
Grout-Intervals: From 20 ft. to 0 ft., From ft. to ft., From ft. to ft.								
What is the nearest source of possible contamination:		10 Livestock pens 14 Abandoned water well						
1 Septic tank 4 Lateral lines 7 Pit privy 11 Fuel storage 15 Oil well/Gas well								
2 Sewer lines 5 Cess pool 8 Sewage lagoon 12 Fertilizer storage 16 Other (specify below)								
3 Watertight sewer lines 6 Seepage pit 9 Feedyard 13 Insecticide storage None								
Direction from well?		How many feet?						
FROM	TO	LITHOLOGIC LOG	FROM	TO	PLUGGING INTERVALS			
0	4	silty clay						
4	15	brown clay - soft						
15	27	light brown sandy clay						
27	64	sand and gravel with few clay streaks						
64	65	yellow clay						
7 CONTRACTOR'S OR LANDOWNER'S CERTIFICATION: This water well was (1) constructed, (2) reconstructed, or (3) plugged under my jurisdiction and was completed on (mo/day/year) 6-10-02 and this record is true to the best of my knowledge and belief. Kansas Water Well Contractor's Licence No. 134 This Water Well Record was completed on (mo/day/yr) 6-20-02 under the business name of Rosencrantz-Bemis by (signature) [Signature]								
INSTRUCTIONS: Use typewriter or ball point pen. PLEASE PRESS FIRMLY and PRINT clearly. Please fill in blanks, underline or circle the correct answers. Send top three copies to Kansas Department of Health and Environment, Bureau of Water, Topeka, Kansas 66620-0001. Telephone 785-296-5524. Send one to WATER WELL OWNER and retain one for your records. Fee of \$5.00 for each constructed well.								