


1 LOCATION OF WATER WELL: Fraction NW 1/4 NE 1/4 NE 1/4 Section Number 35 Township Number T 18 S Range Number R 18 ~~W~~

Distance and direction from nearest town or city street address of well if located within city?
 from Rush Center: 1 mile south, 1 1/2 miles east

2 WATER WELL OWNER: Terry Wagner
 RR#, St. Address, Box #: RR 2 Box 65A
 City, State, ZIP Code: Rush Center KS 67575
 Board of Agriculture, Division of Water Resources
 Application Number:

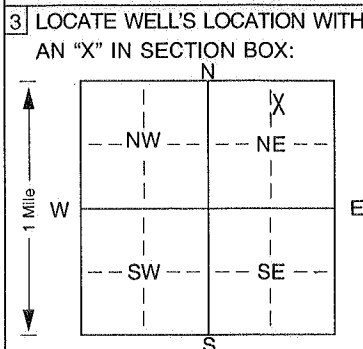

4 DEPTH OF COMPLETED WELL: 220 ft. ELEVATION: upland

Depth(s) Groundwater Encountered 1. ft. 2. ft. 3. ft.

WELL'S STATIC WATER LEVEL: 70 ft. below land surface measured on mo/day/yr 4/2/02

Pump test data: Well water was 70 ft. after 2 hours pumping 15 gpm
 Est. Yield 15 gpm: Well water was ... ft. after ... hours pumping ... gpm
 Bore Hole Diameter: 10 in. to 220 ft., and ... in. to ... ft.

WELL WATER TO BE USED AS: 1 5 Public water supply 8 Air conditioning 11 Injection well
 1 Domestic 3 Feedlot 6 Oil field water supply 9 Dewatering 12 Other (Specify below)
 2 Irrigation 4 Industrial 7 Domestic (lawn & garden) 10 Monitoring well

Was a chemical/bacteriological sample submitted to Department? Yes. No. ; If yes, mo/day/yr sample was submitted
 Water Well Disinfected? Yes No

5 TYPE OF BLANK CASING USED: 2 5 Wrought iron 8 Concrete tile CASING JOINTS: Glued. Clamped.
 1 Steel 3 RMP (SR) 6 Asbestos-Cement 9 Other (specify below) Welded.
 2 PVC 4 ABS 7 Fiberglass Threaded.

Blank casing diameter: 5 in. to 180 ft., Dia. in. to ... ft., Dia. in. to ... ft.

Casing height above land surface: 24 in., weight 2,29 lbs./ft. Wall thickness or gauge No. 26

TYPE OF SCREEN OR PERFORATION MATERIAL: 7 7 PVC 10 Asbestos-cement
 1 Steel 3 Stainless steel 5 Fiberglass 8 RMP (SR) 11 Other (specify)
 2 Brass 4 Galvanized steel 6 Concrete tile 9 ABS 12 None used (open hole)

SCREEN OR PERFORATION OPENINGS ARE: 8 5 Gauzed wrapped 8 Saw cut 11 None (open hole)
 1 Continuous slot 3 Mill slot 6 Wire wrapped 9 Drilled holes
 2 Louvered shutter 4 Key punched 7 Torch cut 10 Other (specify) ft.

SCREEN-PERFORATED INTERVALS: From 220 ft. to 180 ft., From ... ft. to ... ft.
 From ... ft. to ... ft., From ... ft. to ... ft.

GRAVEL PACK INTERVALS: From 60 ft. to 220 ft., From ... ft. to ... ft.
 From ... ft. to ... ft., From ... ft. to ... ft.

6 GROUT MATERIAL: 3 1 Neat cement 2 Cement grout 3 Bentonite 4 Other

Grout Intervals: From 0 ft. to 60 ft., From ... ft. to ... ft., From ... ft. to ... ft.

What is the nearest source of possible contamination:
 1 Septic tank 4 Lateral lines 7 Pit privy 10 Livestock pens 14 Abandoned water well
 2 Sewer lines 5 Cess pool 8 Sewage lagoon 11 Fuel storage 15 Oil well/Gas well
 3 Watertight sewer lines 6 Seepage pit 9 Feedyard 12 Fertilizer storage 16 Other (specify below)
 13 Insecticide storage

Direction from well? How many feet?

FROM	TO	LITHOLOGIC LOG	FROM	TO	PLUGGING INTERVALS
0	3	Topsoil	205	220	Red clay
3	22	Gumbo			
22	38	Rock with clay layers			
38	50	Shale			
50	70	Gray clay			
70	75	Soft shale Hard white rock			
75	80	Soft shale			
80	85	Hardgray rock			
85	90	Gray clay			
90	120	Red clay			
120	150	Red clay/hard sand rock layers			
150	180	Gray clay			
180	190	Sand rock			
190	205	Hard gray clay			

7 CONTRACTOR'S OR LANDOWNER'S CERTIFICATION: This water well was (1) constructed, (2) reconstructed, or (3) plugged under my jurisdiction and was completed on (mo/day/year) 4/2/02 and this record is true to the best of my knowledge and belief. Kansas Water Well Contractor's Licence No. 199 This Water Well Record was completed on (mo/day/yr) 4/24/02 under the business name of Karst Water Well Drilling & Service, Inc by (signature) Mel Karst