

**WATER WELL RECORD**

**Form WWC-5**

Division of Water Resources; App. No.  


<b>1 LOCATION OF WATER WELL:</b> County: <b>Rush</b>	Fraction <b>SE ¼ SE ¼ SE ¼</b>	Section Number <b>21</b>	Township Number <b>T 18 S</b>	Range Number <b>R 18 E/W</b>
---	-----------------------------------	-----------------------------	----------------------------------	---------------------------------

Distance and direction from nearest town or city street address of well if located within city? **50' N of Intersection 183 & 96 Rush Center, Kansas**

**Global Positioning Systems** (decimal degrees, min. of 4 digits)  
 Latitude: \_\_\_\_\_  
 Longitude: \_\_\_\_\_  
 Elevation: \_\_\_\_\_  
 Datum: \_\_\_\_\_  
 Data Collection Method: \_\_\_\_\_

**2 WATER WELL OWNER:** **Renzoil, Inc**  
 RR#, St. Address, Box # : **RR 1 Box 16A**  
 City, State, ZIP Code : **Rush Center, KS 67575**

**3 LOCATE WELL'S LOCATION WITH AN "X" IN SECTION BOX:**      **4 DEPTH OF COMPLETED WELL .30.2..... ft.**

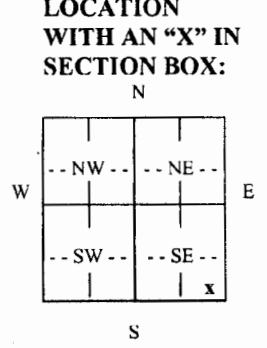

Depth(s) Groundwater Encountered (1).**26.2**..... ft. (2)..... ft. (3)..... ft.  
 WELL'S STATIC WATER LEVEL **26.2**..... ft. below land surface measured on mo/day/yr. **06-20-06**  
 Pump test data: Well water was..... ft. after..... hours pumping..... gpm  
 Est. Yield. **2**..... gpm: Well water was..... ft. after..... hours pumping..... gpm  
 WELL WATER TO BE USED AS: 5 Public water supply      8 Air conditioning      11 Injection well  
 1 Domestic      3 Feedlot      6 Oil field water supply      9 Dewatering      **12 Other** (Specify below)  
 2 Irrigation      4 Industrial      7 Domestic (lawn & garden)      10 Monitoring well      **SVE-5**  
 Was a chemical/bacteriological sample submitted to Department? Yes..... No .....; If yes, mo/day/yr  
 Sample was submitted..... Water well disinfected? Yes..... No .....

**5 TYPE OF CASING USED:**      5 Wrought Iron      8 Concrete tile      CASING JOINTS: Glued..... Clamped.....  
 1 Steel      3 RMP (SR)      6 Asbestos-Cement      9 Other (specify below)      Welded.....  
**2 PVC**      4 ABS      7 Fiberglass      ..... Threaded

Blank casing diameter **4**..... in. to ..... ft., Diameter..... in. to ..... ft., Diameter..... in. to ..... ft.  
 Casing height above land surface..... in., Weight **2.00**..... lbs./ft.      Wall thickness or gauge No. **Sch 40**

**TYPE OF SCREEN OR PERFORATION MATERIAL:**  
 1 Steel      3 Stainless Steel      5 Fiberglass      **7 PVC**      9 ABS      11 Other (Specify).....  
 2 Brass      4 Galvanized Steel      6 Concrete tile      8 RM (SR)      10 Asbestos-Cement      12 None used (open hole)

**SCREEN OR PERFORATION OPENINGS ARE:**  
 1 Continuous slot      **3 Mill slot**      5 Gauzed wrapped      7 Torch cut      9 Drilled holes      11 None (open hole)  
 2 Louvered shutter      4 Key punched      6 Wire wrapped      8 Saw Cut      10 Other (specify).....

**SCREEN-PERFORATED INTERVALS:** From **15.2**..... ft. to **30.2**..... ft., From..... ft. to..... ft.  
 From..... ft. to..... ft., From..... ft. to..... ft.

**GRAVEL PACK INTERVALS:** From **13.6**..... ft. to **30.2**..... ft., From..... ft. to..... ft.  
 From..... ft. to..... ft., From..... ft. to..... ft.

**6 GROUT MATERIAL:**      1 Neat cement      2 Cement grout      **3 Bentonite**      4 Other.....  
 Grout Intervals:      From **13.6**..... ft. to **0.7**..... ft., From **0.7**..... ft. to **0 concrete**..... ft., From..... ft. to..... ft.

What is the nearest source of possible contamination:  
 1 Septic tank      4 Lateral lines      7 Pit privy      **10 Livestock pens**      13 Insecticide Storage      16 Other (specify below)  
 2 Sewer lines      5 Cess pool      8 Sewage lagoon      **11 Fuel storage**      14 Abandoned water well  
 3 Watertight sewer lines      6 Seepage pit      9 Feedyard      12 Fertilizer Storage      15 Oil well/gas well  
 Direction from well? ..... How many feet? .....

FROM	TO	LITHOLOGIC LOG	FROM	TO	PLUGGING INTERVALS
0	0.5	Concrete			
0.5	5	Silt-Clayey Silt			
5	19	Clayey Silt			
19	23	Silt Clayey Silt			
23	30.2	Clayey Silt			

**7 CONTRACTOR'S OR LANDOWNER'S CERTIFICATION:** This water well was (1) constructed, (2) reconstructed, or (3) plugged under my jurisdiction and was completed on (mo/day/year) **06-20-2006**..... and this record is true to the best of my knowledge and belief. Kansas Water Well Contractor's License No. **554**..... This Water Well Record was completed on (mo/day/year) **08-07-06**..... under the business name of **Woofter Pump & Well, Inc.** by (signature) *[Signature]*

**INSTRUCTIONS:** Use typewriter or ball point pen. PLEASE PRESS FIRMLY and PRINT clearly. Please fill in blanks, underline or circle the correct answers. Send top three copies to Kansas Department of Health and Environment, Bureau of Water, Geology Section, 1000 SW Jackson St., Suite 420, Topeka, Kansas 66612-1367. Telephone 785-296-5522. Send one to WATER WELL OWNER and retain one for your records. Fee of \$5.00 for each constructed well. Visit us at <http://www.kdhe.state.ks.us/geo/waterwells>.