


**WATER WELL PLUGGING RECORD Form WWC-5P** KSA 82a-1212 ID NO.

|   |  |                          |                               |   |
|---|--|--------------------------|-------------------------------|---|
| <b>1 LOCATION OF WATER WELL:</b><br>County: <u>Rush</u> | Fraction <u>1/4 SW 1/4 NE 1/4 NE 1/4</u> | Section Number <u>28</u> | Township Number <u>T 18 S</u> | Range Number <u>18</u> <input type="checkbox"/> E <input checked="" type="checkbox"/> W |
|---|--|--------------------------|-------------------------------|---|

Street/Rural Address of Well Location; if unknown, distance & direction from nearest town or intersection: If at owner's address, check here   
 Approximately 1/8 mile south of Rush Center.

**Global Positioning Systems (GPS) information:**  
 Latitude: 38.463301 (in decimal degrees)  
 Longitude: -99.312025 (in decimal degrees)  
 Elevation: unknown  
 Datum:  WGS84,  NAD83,  NAD27  
 Collection Method:  
 GPS unit (Make/Model: WAAS)  
 Digital Map/Photo,  Topographic Map,  Land Survey  
 Est. Accuracy:  < 3 m,  3-5 m,  5-15 m,  > 15 m

**2 WATER WELL OWNER:** City of Rush Center  
 RR#, St. Address, Box #: P.O. Box 125  
 City, State ZIP Code: Rush Center, KS 67575

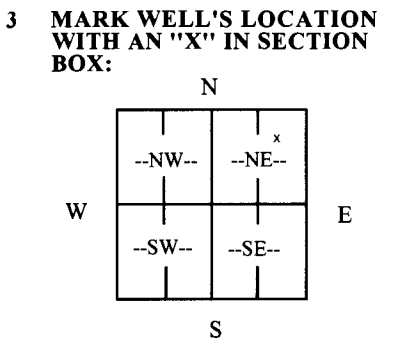

**4 DEPTH OF WELL** 52.50 ft.  
 WELL'S STATIC WATER LEVEL 27 ft.  
 WELL WAS USED AS:  
 Domestic  Public Water Supply  Dewatering  
 Irrigation  Oil Field Water Supply  Monitoring  
 Feedlot  Domestic (Lawn & Garden)  Injection Well  
 Industrial  Air Conditioning  Other \_\_\_\_\_  
 Was a chemical/bacteriological sample submitted to Department? Yes  No

**5 TYPE OF BLANK CASING USED:**

|   |                                   |  |  |  |
|---|-----------------------------------|--|--|--|
| <input type="checkbox"/> Steel          | <input type="checkbox"/> RMP (SR) | <input type="checkbox"/> Wrought         | <input type="checkbox"/> Fiberglass    | <input type="checkbox"/> Other (Specify below) _____ |
| <input checked="" type="checkbox"/> PVC | <input type="checkbox"/> ABS      | <input type="checkbox"/> Asbestos-Cement | <input type="checkbox"/> Concrete Tile |  |

Blank casing diameter 8 in. Was casing pulled? Yes  No  If yes, how much \_\_\_\_\_  
 Casing height above or below land surface. 48 in.

**6 GROUT PLUG MATERIAL:**  Neat cement  Cement grout  Bentonite  Other \_\_\_\_\_  
 Grout Plug Intervals: From \_\_\_\_\_ ft. to \_\_\_\_\_ ft., From 4 ft. to 27 ft., From \_\_\_\_\_ to \_\_\_\_\_ ft.  
 What is the nearest source of possible contamination:  
 Septic tank  Seepage pit  Fuel Storage  Other (specify below) \_\_\_\_\_  
 Sewer lines  Pit privy  Fertilizer storage  None Known  
 Watertight sewer lines  Sewage lagoon  Insecticide storage  
 Lateral lines  Feedyard  Abandoned water well Direction from well? \_\_\_\_\_  
 Cess pool  Livestock pens  Oil well/Gas well How many feet? \_\_\_\_\_

| FROM | TO    | PLUGGING MATERIALS          | FROM | TO | PLUGGING MATERIALS |
|------|-------|-----------------------------|------|----|--------------------|
| 0    | 4     | Topsoil                     |      |    |                    |
| 4    | 27    | Bentonite Chips             |      |    |                    |
| 27   | 52.50 | Chlorinated Sand and Gravel |      |    |                    |
|      |       |                             |      |    |                    |
|      |       |                             |      |    |                    |
|      |       |                             |      |    |                    |

**7 CONTRACTOR'S OR LANDOWNER'S CERTIFICATION:** This water well was plugged under my jurisdiction and was completed on (mo/day/year) 10/11/11 and this record is true to the best of my knowledge and belief. Kansas Water Well Contractor's License No. 185. This Water Well Record was completed on (mo/day/year) 10/12/11 under the business name of Clarke Well & Equipment, Inc. by (signature)

**INSTRUCTIONS:** Use typewriter or ballpoint pen. Please press firmly and print clearly. Please fill in blanks, underline or circle the correct answers. Send top three copies to Kansas Department of Health and Environment, Bureau of Water, Geology Section, 1000 SW Jackson St., Ste. 420, Topeka, Kansas 66612-1367. Telephone: 785/296-5524. Send one to Water Well Owner and retain one for your records. Visit us at <http://www.kdheks.gov/waterwell/1~ndex.html>.

Check one:  White Copy  Blue Copy  Pink Copy