

# WATER WELL PLUGGING RECORD Form WWC-5P

KSA 82a-1212

ID NO.

<b>1 LOCATION OF WATER WELL:</b> County: <u>Rush</u>	Fraction <u>1/4 NW 1/4 NW 1/4 NW 1/4</u>	Section Number <u>34</u>	Township Number <u>T 18 S</u>	Range Number <u>18</u> <input type="checkbox"/> E <input checked="" type="checkbox"/> W
---	---	-----------------------------	----------------------------------	--


Street/Rural Address of Well Location; if unknown, distance & direction from nearest town or intersection: If at owner's address, check here  1S of Rush Center, KS

**Global Positioning Systems (GPS) information:**

Latitude: \_\_\_\_\_ (in decimal degrees)  
 Longitude: \_\_\_\_\_ (in decimal degrees)  
 Elevation: \_\_\_\_\_  
 Datum:  WGS84,  NAD83,  NAD27  
 Collection Method:  
 GPS unit (Make/Model: \_\_\_\_\_)  
 Digital Map/Photo,  Topographic Map,  Land Survey  
 Est. Accuracy:  < 3 m,  3-5 m,  5-15 m,  > 15 m

**2 WATER WELL OWNER:** William (Vern) Melton  
 RR#, St. Address, Box #: 1660 Hwy 183  
 City, State ZIP Code: Rush Center, KS 67575

**3 MARK WELL'S LOCATION WITH AN "X" IN SECTION BOX:**

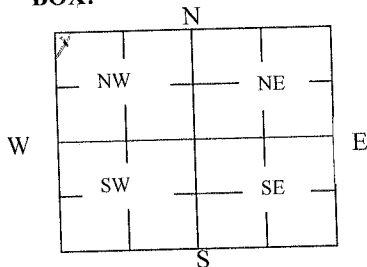

**4 DEPTH OF WELL** 60 ft.

WELL'S STATIC WATER LEVEL 22 ft

WELL WAS USED AS:

- |  |   |   |
|--|---|---|
| <input type="checkbox"/> Domestic              | <input type="checkbox"/> Public Water Supply      | <input type="checkbox"/> Dewatering     |
| <input checked="" type="checkbox"/> Irrigation | <input type="checkbox"/> Oil Field Water Supply   | <input type="checkbox"/> Monitoring     |
| <input type="checkbox"/> Feedlot               | <input type="checkbox"/> Domestic (Lawn & Garden) | <input type="checkbox"/> Injection Well |
| <input type="checkbox"/> Industrial            | <input type="checkbox"/> Air Conditioning         | <input type="checkbox"/> Other _____    |

Was a chemical/bacteriological sample submitted to Department? Yes  No

**5 TYPE OF BLANK CASING USED:**

- Steel  PVC  RMP (SR)  ABS  Wrought  Asbestos-Cement  Fiberglass  Concrete Tile  Other (Specify below) \_\_\_\_\_

Blank casing diameter 16 in. Was casing pulled? Yes  No  If yes, how much \_\_\_\_\_  
 Casing height above or below land surface 1 ft below in.

**6 GROUT PLUG MATERIAL:**

- Neat cement  Cement grout  Bentonite  Other \_\_\_\_\_

Grout Plug Intervals: From 1 ft. to 28 ft., From 28 ft. to 30 ft., From \_\_\_\_\_ to \_\_\_\_\_ ft.

What is the nearest source of possible contamination:

- |   |   |   |   |
|---|---|---|---|
| <input type="checkbox"/> Septic tank            | <input type="checkbox"/> Seepage pit    | <input type="checkbox"/> Fuel Storage         | <input checked="" type="checkbox"/> Other (specify below) _____<br>in field |
| <input type="checkbox"/> Sewer lines            | <input type="checkbox"/> Pit privy      | <input type="checkbox"/> Fertilizer storage   |   |
| <input type="checkbox"/> Watertight sewer lines | <input type="checkbox"/> Sewage lagoon  | <input type="checkbox"/> Insecticide storage  | Direction from well? _____<br>How many feet? _____                          |
| <input type="checkbox"/> Lateral lines          | <input type="checkbox"/> Feedyard       | <input type="checkbox"/> Abandoned water well |   |
| <input type="checkbox"/> Cess pool              | <input type="checkbox"/> Livestock pens | <input type="checkbox"/> Oil well/Gas well    |   |

FROM	TO	PLUGGING MATERIALS	FROM	TO	PLUGGING MATERIALS
60	30	gravel			
30	28	bentonite			Cutoff variance called for and received from Mr. Richard Harper
28	1	cement			KDHE
1	0	top soil			

**7 CONTRACTOR'S OR LANDOWNER'S CERTIFICATION:** This water well was plugged under my jurisdiction and was completed on (mo/day/year) 12/02/11 and this record is true to the best of my knowledge and belief. Kansas Water Well Contractor's License No. 186. This Water Well Record was completed on (mo/day/year) 12/11/11 under the business name of Kelly's Water Well Service, Inc. by (signature) Kathryn R. Harper

**INSTRUCTIONS:** Use typewriter or ballpoint pen. Please press firmly and print clearly. Please fill in blanks, underline or circle the correct answers. Send top three copies to Kansas Department of Health and Environment, Bureau of Water, Geology Section, 1000 SW Jackson St., Ste. 420, Topeka, Kansas 66612-1367. Telephone: 785/296-5524. Send one to Water Well Owner and retain one for your records. Visit us at <http://www.kdheks.gov/waterwell/index.html>.

Check one:  White Copy  Blue Copy  Pink Copy