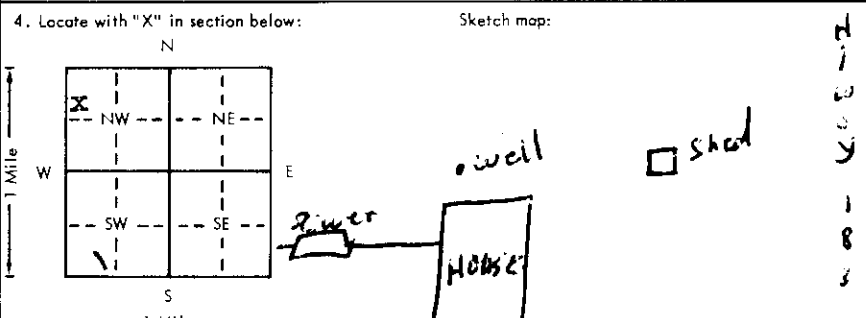


USE TYPEWRITER OR BALL
POINT PEN-PRESS FIRMLY,
PRINT CLEARLY.

WATER WELL RECORD
KSA 82a-1201-1215

Kansas Department of Health and
Environment-Division of Environment
(Water well Contractors)
Topeka, Kansas 66620

1. Location of well:		County Rush	Fraction SW 1/4 NW 1/4 NW 1/4	Section number 10	Township number T 18 S	Range number R 18 E
2. Distance and direction from nearest town or city: Street address of well location if in city:		2 miles south La Crosse, Ks.		3. Owner of well: Henry Refschneider R.R. or street: RR La Crosse, Ks. City, state, zip code:		
4. Locate with "X" in section below: N W E S 1 Mile 1 Mile		Sketch map: 		6. Bare hole dia. 8 in. Completion date 10-4-79 Well depth 300 ft.		
5. Type and color of material		From	To	7. Cable tool <input checked="" type="checkbox"/> Rotary <input type="checkbox"/> Driven <input type="checkbox"/> Dug <input type="checkbox"/> Hollow rod <input type="checkbox"/> Jetted <input type="checkbox"/> Bored <input type="checkbox"/> Reverse rotary		
topsoil		0	4	8. Use: <input checked="" type="checkbox"/> Domestic <input type="checkbox"/> Public supply <input type="checkbox"/> Industry <input type="checkbox"/> Irrigation <input type="checkbox"/> Air conditioning <input type="checkbox"/> Stock <input type="checkbox"/> Lawn <input type="checkbox"/> Oil field water <input type="checkbox"/> Other		
clay		4	57	9. Casing: Material pvc Height: Above or below Threaded <input type="checkbox"/> Welded <input checked="" type="checkbox"/> Surface 18 in. RMP pvc Weight 200 lbs./ft. Dia. 5 in. to 300 ft. depth Wall Thickness: inches or Dia. 5 in. to 300 ft. depth Gage No. .26		
shale		57	206	10. Screens: Manufacturer's name jet stream Type pvc Dia. 5 Slot .031 Length 20 Set between 280 ft. and 300 ft. Gravel pack? <input checked="" type="checkbox"/> Size range of material 1/4-1/2		
red and white Dakota clay		206	265	11. Static water level: 160 ft. below land surface Date 10-4-79 mo./day/yr.		
whitw clay and sandstone		265	300	12. Pumping level below land surfaces: 170 ft. after 24 hrs. pumping 15 g.p.m. ft. after hrs. pumping g.p.m. Estimated maximum yield 15 g.p.m.		
112 g.s.l				13. Water sample submitted: mo./day/yr. <input type="checkbox"/> Yes <input checked="" type="checkbox"/> No Date 		
				14. Well head completion: <input checked="" type="checkbox"/> Pitless adapter inches above grade		
				15. Well grouted? <input checked="" type="checkbox"/> With <input checked="" type="checkbox"/> Neat cement <input type="checkbox"/> Bentonite <input type="checkbox"/> Concrete Depth: From 4 ft. to 15 ft.		
				16. Nearest source of possible contamination: ft. 100 Direction NE Type sewer Well disinfected upon completion? <input checked="" type="checkbox"/> Yes <input type="checkbox"/> No		
				17. Pump: <input checked="" type="checkbox"/> Not installed Manufacturer's name HP Volts Length of drop pipe ft. capacity g.p.m. Type: <input type="checkbox"/> Submersible <input type="checkbox"/> Turbine <input type="checkbox"/> Jet <input type="checkbox"/> Reciprocating <input type="checkbox"/> Centrifugal <input type="checkbox"/> Other		
18. Elevation:		19. Remarks:		20. Water well contractor's certification: This well was drilled under my jurisdiction and this report is true to the best of my knowledge and belief. Karst Water Well 199 Business name E. Hiway 40 Hays, Ks. License No. Address Signed Date 10-4-79 Authorized representative		

Forward the white, blue and pink copies to the Department of Health and Environment

Form WWC-5