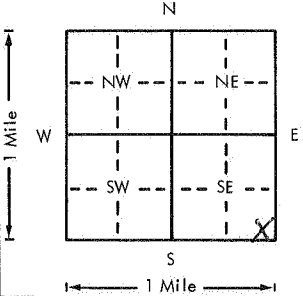


USE TYPEWRITER OR BALL POINT PEN—PRESS FIRMLY, PRINT CLEARLY.

WATER WELL RECORD
KSA 82a-1201-1215

rush center

Kansas Department of Health and Environment—Division of Environment
(Water well Contractors)
Topeka, Kansas 66620

1. Location of well:		County <i>Rush</i>	Fraction <i>SE 1/4 SE 1/4 SE 1/4</i>	Section number <i>26</i>	Township number T <i>18</i> S R	Range number <i>18</i> E <i>(W)</i>
2. Distance and direction from nearest town or city: <i>1 mi S, 2 mi E from Rush Center, Ks</i> Street address of well location if in city: <i>west into field</i>			3. Owner of well: <i>Red Barron</i> R.R. or street: <i>none</i> City, state, zip code: <i>Rush Center, Ks 67575</i>			
4. Locate with "X" in section below: Sketch map: 			6. Bore hole dia. <i>9</i> in. Completion date Well depth <i>195</i> ft. <i>8-2-77</i>			
5. Type and color of material			From	To	7. <input type="checkbox"/> Cable tool <input checked="" type="checkbox"/> Rotary <input type="checkbox"/> Driven <input type="checkbox"/> Dug <input type="checkbox"/> Hollow rod <input type="checkbox"/> Jetted <input type="checkbox"/> Bored <input type="checkbox"/> Reverse rotary	
<i>Top soil</i>			<i>0</i>	<i>2</i>	8. Use: <input type="checkbox"/> Domestic <input type="checkbox"/> Public supply <input type="checkbox"/> Industry <input type="checkbox"/> Irrigation <input type="checkbox"/> Air conditioning <input checked="" type="checkbox"/> Stock <input type="checkbox"/> Lawn <input type="checkbox"/> Oil field water <input type="checkbox"/> Other	
<i>Brown clay</i>			<i>2</i>	<i>5</i>	9. Casing: Material <i>PVC</i> Height: Above or below Threaded <input type="checkbox"/> Welded <input type="checkbox"/> Surface <i>18</i> in. RMP <i>PVC</i> <input checked="" type="checkbox"/> Weight <i>50/40</i> lbs./ft. Dia. <i>4 1/2</i> in. to <i>195</i> ft. depth Wall Thickness: inches or Dia. <input type="checkbox"/> in. to <input type="checkbox"/> ft. depth Gage No. <i>237</i>	
<i>Light Brown clay</i>			<i>5</i>	<i>20</i>	10. Screen: Manufacturer's name <i>Retain-Teed</i> Type <i>PVC</i> Dia. <input type="checkbox"/> Slot/gauze <i>1/16</i> Length <i>20</i> Set between <i>175</i> ft. and <i>195</i> ft. <input type="checkbox"/> ft. and <input type="checkbox"/> ft. Gravel pack? <input checked="" type="checkbox"/> Size range of material <i>1/4 3/8 1/2</i>	
<i>Broken rock</i>			<i>20</i>	<i>22</i>	11. Static water level: <input type="checkbox"/> mo./day/yr. <i>52</i> ft. below land surface Date <i>8-2-77</i>	
<i>Brown clay</i>			<i>22</i>	<i>26</i>	12. Pumping level below land surfaces: <i>80</i> ft. after <i>1</i> hrs. pumping <i>10</i> g.p.m. <input type="checkbox"/> ft. after <input type="checkbox"/> hrs. pumping <input type="checkbox"/> g.p.m. Estimated maximum yield <i>15</i> g.p.m.	
<i>Blue shale</i>			<i>26</i>	<i>75</i>	13. Water sample submitted: <input type="checkbox"/> mo./day/yr. <input type="checkbox"/> Yes <input checked="" type="checkbox"/> No Date <input type="checkbox"/>	
<i>Black shale</i>			<i>75</i>	<i>92</i>	14. Well head completion: <input type="checkbox"/> Pitless adapter <input type="checkbox"/> inches above grade	
<i>White clay</i>			<i>92</i>	<i>115</i>	15. Well grouted? <input checked="" type="checkbox"/> With: <input checked="" type="checkbox"/> Neat cement <input type="checkbox"/> Bentonite <input type="checkbox"/> Concrete Depth: From <i>0</i> ft. to <i>10</i> ft.	
<i>Brown Red clay</i>			<i>115</i>	<i>150</i>	16. Nearest source of possible contamination: ft. <i>300</i> Direction <i>NW</i> Type <i>Septic</i> Well disinfected upon completion? <input checked="" type="checkbox"/> Yes <input type="checkbox"/> No	
<i>Light blue gray clay</i>			<i>150</i>	<i>174</i>	17. Pump: <input checked="" type="checkbox"/> Not installed Manufacturer's name <input type="checkbox"/> HP <input type="checkbox"/> Volts <input type="checkbox"/> Length of drop pipe <input type="checkbox"/> ft. capacity <input type="checkbox"/> g.p.m. Type: <input type="checkbox"/> Submersible <input type="checkbox"/> Turbine <input type="checkbox"/> Jet <input type="checkbox"/> Reciprocating <input type="checkbox"/> Centrifugal <input type="checkbox"/> Other	
<i>Sand. rock</i>			<i>174</i>	<i>187</i>		
<i>Sandy shale - light gray</i>			<i>187</i>	<i>190</i>		
<i>Sand. rock</i>			<i>190</i>	<i>194</i>		
<i>Shale</i>			<i>194</i>			
<i>NO gal</i>						
(Use a second sheet if needed)						
18. Elevation:		19. Remarks: <i>2017</i>				
Topography: <input checked="" type="checkbox"/> Hill <input type="checkbox"/> Slope <input type="checkbox"/> Upland <input type="checkbox"/> Valley		20. Water well contractor's certification: This well was drilled under my jurisdiction and this report is true to the best of my knowledge and belief. <i>Rosenkrantz-Bemis</i> <i>134</i> Business name License No. Address <i>Great Bend, Ks 67530</i> Signed <i>Sandy Kilgore</i> Date <i>8-5-77</i> Authorized representative				

T 18
R 18
E 26
Sec 1/4 1/4 1/4