

1 LOCATION OF WATER WELL:	Fraction	Section Number	Township Number	Range Number
County: Rush	NW 1/4 NW 1/4 NW 1/4	27	T 18 S	R 18 EW

Distance and direction from nearest town or city street address of well if located within city?

Rush Center, Ks. GS 46

## 2 WATER WELL OWNER: Harley Renz


RR#, St. Address, Box #: RR#2, Box 1

Board of Agriculture, Division of Water Resources

City, State, ZIP Code: Rush Center, Ks.

Application Number:

## 3 LOCATE WELL'S LOCATION WITH AN "X" IN SECTION BOX:

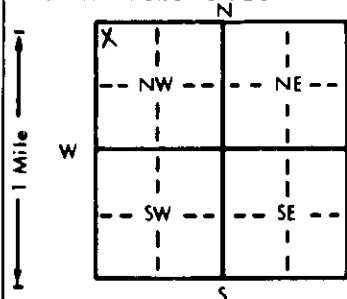

## 4 DEPTH OF COMPLETED WELL: 37 ft. ELEVATION:

Depth(s) Groundwater Encountered 1. 30 ft. 2. ft. 3. ft.

WELL'S STATIC WATER LEVEL ft. below land surface measured on mo/day/yr

Pump test data: Well water was ft. after hours pumping gpm

Est. Yield gpm: Well water was ft. after hours pumping gpm

Bore Hole Diameter: 7.5/8 in. to 37 ft. and in. to ft.

WELL WATER TO BE USED AS: 5 Public water supply 8 Air conditioning 11 Injection well

1 Domestic 3 Feedlot 6 Oil field water supply 9 Dewatering 12 Other (Specify below)

2 Irrigation 4 Industrial 7 Lawn and garden only 10 Monitoring well

Was a chemical/bacteriological sample submitted to Department? Yes No; If yes, mo/day/yr sample was submitted

Water Well Disinfected? Yes No

## 5 TYPE OF BLANK CASING USED:

- 1 Steel  
2 PVC  
3 RMP (SR)  
4 ABS

- 5 Wrought iron  
6 Asbestos-Cement  
7 Fiberglass  
8 Concrete tile  
9 Other (specify below)

- CASING JOINTS: Glued Clamped  
Welded  
Threaded

Blank casing diameter 2 in. to 22 ft., Dia in. to ft., Dia in. to ft.

Casing height above land surface 24 in., weight lbs./ft. Wall thickness or gauge No. Schedule 40

## TYPE OF SCREEN OR PERFORATION MATERIAL:

- 1 Steel  
2 Brass  
3 Stainless steel  
4 Galvanized steel

- 5 Fiberglass  
6 Concrete tile  
7 PVC  
8 RMP (SR)  
9 ABS

- 10 Asbestos-cement  
11 Other (specify)  
12 None used (open hole)

## SCREEN OR PERFORATION OPENINGS ARE:

- 1 Continuous slot  
2 Louvered shutter  
3 Mill slot  
4 Key punched

- 5 Gauzed wrapped  
6 Wire wrapped  
7 Torch cut  
8 Saw cut  
9 Drilled holes  
10 Other (specify)  
11 None (open hole)

SCREEN-PERFORATED INTERVALS: From 22 ft. to 37 ft., From ft. to ft.

From ft. to ft., From ft. to ft.

GRAVEL PACK INTERVALS: From 20 ft. to 37 ft., From ft. to ft.

From ft. to ft., From ft. to ft.

## 6 GROUT MATERIAL:

- 1 Neat cement  
2 Cement grout  
3 Bentonite  
4 Other

Grout Intervals: From 0 ft. to 16 (cement) ft., From 16 ft. to 20 (bent) ft., From ft. to ft.

What is the nearest source of possible contamination:

- 1 Septic tank  
2 Sewer lines  
3 Watertight sewer lines  
4 Lateral lines  
5 Cess pool  
6 Seepage pit  
7 Pit privy  
8 Sewage lagoon  
9 Feedyard  
10 Livestock pens  
11 Fuel storage  
12 Fertilizer storage  
13 Insecticide storage  
14 Abandoned water well  
15 Oil well/Gas well  
16 Other (specify below)

Direction from well? N

How many feet? 225

FROM	TO	LITHOLOGIC LOG	FROM	TO	PLUGGING INTERVALS
0	6	clay			
6	13	silty clay			above-ground cover KDHE Tag # 00098038
13	17	clayey silt			
17	23	slightly silty clay			
23	27	clay			
27	37	sand			

7 CONTRACTOR'S OR LANDOWNER'S CERTIFICATION: This water well was (1) constructed, (2) reconstructed, or (3) plugged under my jurisdiction and was completed on (mo/day/year) 5-13-92 and this record is true to the best of my knowledge and belief. Kansas

Water Well Contractor's License No. 527 This Water Well Record was completed on (mo/day/yr) 06-03-92

under the business name of GeoCore Services, Inc. by (signature) Dale R. R.

INSTRUCTIONS: Use typewriter or ball point pen. PLEASE PRESS FIRMLY and PRINT clearly. Please fill in blanks, underline or circle the correct answers. Send top three copies to Kansas Department of Health and Environment, Bureau of Water, Topeka, Kansas 66620-0001. Telephone: 913-296-5545. Send one to WATER WELL OWNER and retain one for your records.

OFFICE USE ONLY

T

R

EW

SEC.

1/4

1/4

1/4