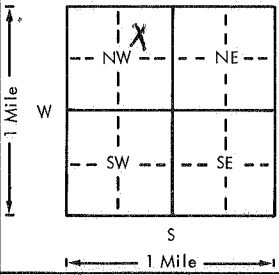
 


USE TYPEWRITER OR BALL  
POINT PEN-PRESS FIRMLY,  
PRINT CLEARLY.

WATER WELL RECORD  
KSA 82a-1201-1215

Kansas Department of Health and  
Environment-Division of Environment  
(Water well Contractors)  
Topeka, Kansas 66620

1. Location of well:		County <i>Rush</i>	Fraction <i>C 1/4 NE 1/4 NW 1/4</i>	Section number <i>29</i>	Township number <i>T 15 18 S</i>	Range number <i>R 18</i>	E/W <i>E/W</i>
2. Distance and direction from nearest town or city: <i>2 mi. W. 1/2 S. Rush Center</i> Street address of well location if in city: <i>E. Side KS.</i>				3. Owner of well: <i>Bill Reynolds</i> R.R. or street: City, state, zip code: <i>Rush Center, Mo. 67576</i>			
4. Locate with "X" in section below: 				Sketch map: 			
5. Type and color of material				From	To	6. Bore hole dia. <i>8</i> in. Completion date Well depth <i>48</i> ft. <i>2-7-77</i>	
<i>Top soil</i>				<i>0</i>	<i>3</i>	7. <input checked="" type="checkbox"/> Cable tool <input checked="" type="checkbox"/> Rotary <input type="checkbox"/> Driven <input type="checkbox"/> Dug <input type="checkbox"/> Hollow rod <input type="checkbox"/> Jetted <input type="checkbox"/> Bored <input type="checkbox"/> Reverse rotary	
<i>Clay</i>				<i>3</i>	<i>28</i>	8. Use: <input checked="" type="checkbox"/> Domestic <input type="checkbox"/> Public supply <input type="checkbox"/> Industry <input type="checkbox"/> Irrigation <input type="checkbox"/> Air conditioning <input type="checkbox"/> Stock <input type="checkbox"/> Lawn <input type="checkbox"/> Oil field water <input type="checkbox"/> Other	
<i>Good sand &amp; gravel</i>				<i>28</i>	<i>48</i>	9. Casing: Material <input type="checkbox"/> Threaded <input checked="" type="checkbox"/> Welded <input type="checkbox"/> Surface <i>18</i> in. RMP <input type="checkbox"/> PVC <input checked="" type="checkbox"/> Weight <i>160</i> lbs./ft. Dia. <i>4</i> in. to <i>48</i> ft. depth Wall Thickness: inches or Dia. <i>4</i> in. to <i>48</i> ft. depth gage No. <i>473</i>	
<i>Green clay</i>				<i>48</i>		10. Screen: Manufacturer's name <i>Peerless</i> Type <i>pvc</i> Dia. <i>4</i> Slot/gauze <i>1/16</i> Length <i>20</i> Set between <i>28</i> ft. and <i>48</i> ft. Gravel pack? <input checked="" type="checkbox"/> Size range of material <i>3/4 1/2</i>	
						11. Static water level: <i>30</i> ft. below land surface Date <i>2-7-77</i>	
						12. Pumping level below land surfaces: <i>40</i> ft. after <i>1</i> hrs. pumping <i>10</i> g.p.m. ft. after hrs. pumping g.p.m. Estimated maximum yield <i>12</i> g.p.m.	
						13. Water sample submitted: <i>Yes</i> <input checked="" type="checkbox"/> <i>No</i> <input type="checkbox"/> Date <i>2-7-77</i>	
						14. Well head completion: <input checked="" type="checkbox"/> Pitless adapter <i>18</i> inches above grade	
						15. Well grouted? <input checked="" type="checkbox"/> <i>MNS</i> With: <input checked="" type="checkbox"/> Neat cement <input type="checkbox"/> Bentonite <input type="checkbox"/> Concrete Depth: From <i>0</i> ft. to <i>10</i> ft.	
						16. Nearest source of possible contamination: ft. <i>300</i> Direction <i>SE</i> Type <i>septic tank</i> Well disinfected upon completion? <input checked="" type="checkbox"/> Yes <input type="checkbox"/> No	
						17. Pump: <input checked="" type="checkbox"/> Not installed Manufacturer's name Model number HP Volts Length of drop pipe ft. capacity g.p.m. Type: <input type="checkbox"/> Submersible <input type="checkbox"/> Turbine <input type="checkbox"/> Jet <input type="checkbox"/> Reciprocating <input type="checkbox"/> Centrifugal <input type="checkbox"/> Other	
(Use a second sheet if needed)							
18. Elevation:		19. Remarks: <i>2006</i>		20. Water well contractor's certification: This well was drilled under my jurisdiction and this report is true to the best of my knowledge and belief. <i>Rosenkrantz - Bemis</i> Business name Address <i>Great Bend, Mo.</i> Signed <i>Tedra Rodean</i> Date <i>3/9/77</i> Authorized representative			

Forward the white, blue and pink copies to the Department of Health and Environment

Form WWC-5