


1 LOCATION OF WATER WELL: Fraction Lot 2 1/4 SW 1/4 NW 1/4 Section Number 30 Township Number T 18 S Range Number R 18W EW
 County: Rush

Distance and direction from nearest town or city street address of well if located within city?
 2 1/2 W of Rush Center, Kansas

2 WATER WELL OWNER: John Collins
 RR#, St. Address, Box #: Route 1
 City, State, ZIP Code: Rush Center, Ks. 67575
 Board of Agriculture, Division of Water Resources
 Application Number: 1691

3 LOCATE WELL'S LOCATION WITH AN "X" IN SECTION BOX:

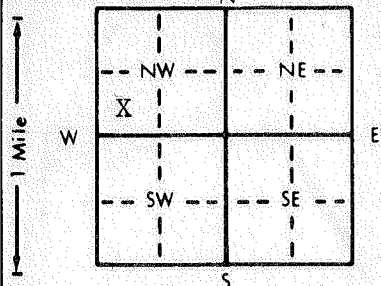

4 DEPTH OF COMPLETED WELL: 66 ft. ELEVATION: Unknown
 Depth(s) Groundwater Encountered 1. 30 ft. 2. ft. 3. ft.
 WELL'S STATIC WATER LEVEL: 30 ft. below land surface measured on mo/day/yr 6/6/91
 Pump test data: Well water was ft. after hours pumping gpm
 Est. Yield: 600 gpm: Well water was ft. after hours pumping gpm
 Bore Hole Diameter: 30 in. to 66 ft. and in. to ft.
 WELL WATER TO BE USED AS:
 1 Domestic 2 Irrigation 3 Feedlot 4 Industrial 5 Public water supply 6 Oil field water supply 7 Lawn and garden only 8 Air conditioning 9 Dewatering 10 Monitoring well 11 Injection well 12 Other (Specify below)
 Was a chemical/bacteriological sample submitted to Department? Yes No; If yes, mo/day/yr sample was submitted
 Water Well Disinfected? Yes No

5 TYPE OF BLANK CASING USED:
 1 Steel 2 PVC 3 RMP (SR) 4 ABS 5 Wrought iron 6 Asbestos-Cement 7 Fiberglass 8 Concrete tile 9 Other (specify below)
 CASING JOINTS: Glued Clamped Welded Threaded
 Blank casing diameter: 16 in. to 46 ft., Dia. in. to ft., Dia. in. to ft.
 Casing height above land surface: 12 in., weight 16.5 lbs./ft. Wall thickness or gauge No. Sch. 40

TYPE OF SCREEN OR PERFORATION MATERIAL:
 1 Steel 2 Brass 3 Stainless steel 4 Galvanized steel 5 Fiberglass 6 Concrete tile 7 PVC 8 RMP (SR) 9 ABS 10 Asbestos-cement 11 Other (specify) 12 None used (open hole)

SCREEN OR PERFORATION OPENINGS ARE:
 1 Continuous slot 2 Louvered shutter 3 Mill slot 4 Key punched 5 Gauzed wrapped 6 Wire wrapped 7 Torch cut 8 Saw cut 9 Drilled holes 10 Other (specify) 11 None (open hole)

SCREEN-PERFORATED INTERVALS: From 46 ft. to 66 ft. From ft. to ft.
 GRAVEL PACK INTERVALS: From 20 ft. to 66 ft. From ft. to ft.

6 GROUT MATERIAL: 1 Neat cement 2 Cement grout 3 Bentonite 4 Other
 Grout Intervals: From 0 ft. to 20 ft. From ft. to ft. From ft. to ft.
 What is the nearest source of possible contamination:
 1 Septic tank 2 Sewer lines 3 Watertight sewer lines 4 Lateral lines 5 Cess pool 6 Seepage pit 7 Pit privy 8 Sewage lagoon 9 Feedyard 10 Livestock pens 11 Fuel storage 12 Fertilizer storage 13 Insecticide storage 14 Abandoned water well 15 Oil well/Gas well 16 Other (specify below) Middle of field

Direction from well?		How many feet?		LITHOLOGIC LOG		PLUGGING INTERVALS	
FROM	TO	FROM	TO	FROM	TO	FROM	TO
0	25			Clay			
25	66			Sand and gravel with clay streaks			

7 CONTRACTOR'S OR LANDOWNER'S CERTIFICATION: This water well was (1) constructed, (2) reconstructed, or (3) plugged under my jurisdiction and was completed on (mo/day/year) 6/6/91 and this record is true to the best of my knowledge and belief. Kansas Water Well Contractor's License No. 186 This Water Well Record was completed on (mo/day/yr) 7/31/91 under the business name of Kelly's Water Well Service by (signature) [Signature]