


1 LOCATION OF WATER WELL: County: RUSH Fraction: SW 1/4 NE 1/4 NW 1/4 Section Number: 18 Township Number: T 18 S Range Number: R 18 EW

Distance and direction from nearest town or city street address of well if located within city?  
2 MI NORTH + 2 1/2 MI WEST OF RUSH CENTER

2 WATER WELL OWNER: CHARLETE PETERS  
 RR#, St. Address, Box #: 112 WEST EIGHTH  
 City, State, ZIP Code: LA CROSSE IA 51791  
 Board of Agriculture, Division of Water Resources  
 Application Number:

3 LOCATE WELL'S LOCATION WITH AN "X" IN SECTION BOX: DEPTH OF COMPLETED WELL: 999 ft. ELEVATION:

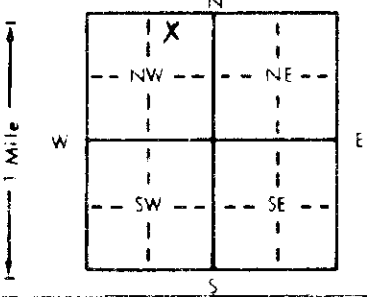

Depth(s) Groundwater Encountered: 1 ft. 2. . . . . ft. 3. . . . . ft.  
 WELL'S STATIC WATER LEVEL: 999 ft. below land surface measured on mo/day/yr  
 Pump test data. Well water was . . . . . ft. after . . . . . hours pumping . . . . . gpm  
 Est Yield . . . . . gpm: Well water was . . . . . ft. after . . . . . hours pumping . . . . . gpm  
 Bore Hole Diameter . . . . . in. to . . . . . ft., and . . . . . in. to . . . . . ft.  
 WELL WATER TO BE USED AS: 5 Public water supply 8 Air conditioning 11 Injection well  
 1 Domestic 3 Feedlot 6 Oil field water supply 9 Dewatering 12 Other (Specify below)  
 2 Irrigation 4 Industrial 7 Lawn and garden only 10 Monitoring well  
 Was a chemical/bacteriological sample submitted to Department? Yes . . . . . No . . . . . ; If yes, mo/day/yr sample was sub-  
 mitted . . . . . Water Well Disinfected? Yes . . . . . No

5 TYPE OF BLANK CASING USED: 5 Wrought iron 8 Concrete tile CASING JOINTS: Glued . . . . . Clamped  
 1 Steel 3 RMP (SR) 6 Asbestos-Cement 9 Other (specify below) Welded . . . . .  
 2 PVC 4 ABS 7 Fiberglass Threaded . . . . .

Blank casing diameter: 4 in. to . . . . . ft. Dia. . . . . in. to . . . . . ft. Dia. . . . . in. to . . . . . ft.  
 Casing height above land surface: 24" in. weight . . . . . lbs./ft. Wall thickness or gauge No. . . . .

TYPE OF SCREEN OR PERFORATION MATERIAL: 7 PVC 10 Asbestos-cement  
 1 Steel 3 Stainless steel 5 Fiberglass 8 RMP (SR) 11 Other (specify) NA  
 2 Brass 4 Galvanized steel 6 Concrete tile 9 ABS 12 None used (open hole)

SCREEN OR PERFORATION OPENINGS ARE: 5 Gauzed wrapped 8 Saw cut 11 None (open hole)  
 1 Continuous slot 3 Mill slot 6 Wire wrapped 9 Drilled holes  
 2 Louvered shutter 4 Key punched 7 Torch cut 10 Other (specify) NA

SCREEN-PERFORATED INTERVALS: From: NA ft. to NA ft. From . . . . . ft. to . . . . . ft.  
 From . . . . . ft. to . . . . . ft. From . . . . . ft. to . . . . . ft.  
 GRAVEL PACK INTERVALS: From . . . . . ft. to . . . . . ft. From . . . . . ft. to . . . . . ft.  
 From . . . . . ft. to . . . . . ft. From . . . . . ft. to . . . . . ft.

6 GROUT MATERIAL: 1 Neat cement 2 Cement grout 3 Bentonite 4 Other  
 Grout intervals: From: 0 ft. to 4 ft. From . . . . . ft. to . . . . . ft. From . . . . . ft. to . . . . . ft.

What is the nearest source of possible contamination: 10 Livestock pens 14 Abandoned water well  
 1 Septic tank 4 Lateral lines 7 Pit privy 11 Fuel storage 15 Oil well/Gas well  
 2 Sewer lines 5 Cess pool 8 Sewage lagoon 12 Fertilizer storage 16 Other (specify below)  
 3 Watertight sewer lines 6 Seepage pit 9 Feedyard 13 Insecticide storage NONE

Direction from well? How many feet?

FROM	TO	LITHOLOGIC LOG	FROM	TO	PLUGGING INTERVALS
					<p><u>EXTENDED WELL CASING</u>  <u>2 FT. 8 FT. ABOVE GROUND</u>  <u>WELDED STEEL FLANGE</u>  <u>ON 4" STEEL PIPE</u>  <u>ADDED 4 FT. OF STEEL</u>  <u>PIPE + VENTED WELL</u>  <u>CAP. WITH SEAL BETWEEN</u>  <u>FLANGES.</u></p>

7 CONTRACTOR'S OR LANDOWNER'S CERTIFICATION: This water well was (1) constructed, (2) reconstructed, or (3) plugged under my jurisdiction and was completed on (mo/day/year) 9-21-94 and this record is true to the best of my knowledge and belief. Kansas Water Well Contractor's License No. 423 This Water Well Record was completed on (mo/day/yr) 10-12-94 under the business name of CLIVE DRILLING CO. by (signature) Clive D. Clive

OFFICE USE ONLY  
T  
R  
EW  
SEC.