

**WATER WELL PLUGGING RECORD Form WWC-5P KSA 82a-1212 ID NO.**

1. **LOCATION OF WATER WELL:** Fraction NE 1/4 1/4 1/4 1/4 Section Number 14 Township Number T 18 S Range Number 19 ☐ E ☐ W

Street/Rural Address of Well Location; if unknown, distance & direction from nearest town or intersection: If at owner's address, check here ☒

**Global Positioning Systems (GPS) information:**

Latitude: \_\_\_\_\_ (in decimal degrees)

Longitude: \_\_\_\_\_ (in decimal degrees)

Elevation: \_\_\_\_\_

Datum: ☐ WGS84, ☐ NAD83, ☐ NAD27

**Collection Method:**


☐ GPS unit (Make/Model: \_\_\_\_\_)

☐ Digital Map/Photo, ☐ Topographic Map, ☐ Land Survey

Est. Accuracy: ☐ < 3 m, ☐ 3-5 m, ☐ 5-15 m, ☐ > 15 m

2. **WATER WELL OWNER:** Rusty & Janet Griffin  
RR#, St. Address, Box #: 507 Main PO Box 135  
City, State ZIP Code: Princeton KS 66078

3. **MARK WELL'S LOCATION WITH AN "X" IN SECTION BOX:**

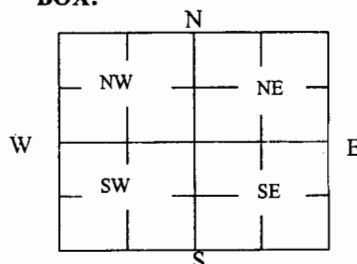

4. **DEPTH OF WELL** 24 ft.

WELL'S STATIC WATER LEVEL 7 ft

**WELL WAS USED AS:**

☒ Domestic  
☐ Irrigation  
☐ Feedlot  
☐ Industrial

☐ Public Water Supply  
☐ Oil Field Water Supply  
☐ Domestic (Lawn & Garden)  
☐ Air Conditioning

☐ Dewatering  
☐ Monitoring  
☐ Injection Well  
☐ Other \_\_\_\_\_

Was a chemical/bacteriological sample submitted to Department? Yes ☐ No ☒

5. **TYPE OF BLANK CASING USED:**

☐ Steel  
☐ PVC

☐ RMP (SR)  
☐ ABS

☐ Wrought  
☐ Asbestos-Cement

☐ Fiberglass  
☐ Concrete Tile

☒ Other (Specify below)  
Rock (Old Hand Dug Well)

Blank casing diameter \_\_\_\_\_ in. Was casing pulled? Yes ☐ No ☐ If yes, how much \_\_\_\_\_  
Casing height above or below land surface \_\_\_\_\_ in.

6. **GROUT PLUG MATERIAL:** ☐ Neat cement ☐ Cement grout ☒ Bentonite ☐ Other \_\_\_\_\_

Grout Plug Intervals: From 4.5 ft. to 5 ft., From \_\_\_\_\_ ft. to \_\_\_\_\_ ft., From \_\_\_\_\_ to \_\_\_\_\_ ft.

**What is the nearest source of possible contamination:**

☐ Septic tank  
☐ Sewer lines  
☐ Watertight sewer lines  
☐ Lateral lines  
☐ Cess pool

☐ Seepage pit  
☐ Pit privy  
☐ Sewage lagoon  
☐ Feedyard  
☐ Livestock pens

☐ Fuel Storage  
☐ Fertilizer storage  
☐ Insecticide storage  
☐ Abandoned water well  
☐ Oil well/Gas well

☒ Other (specify below)  
applied chemicals

Direction from well? all

How many feet? 0 well was in lawn

FROM	TO	PLUGGING MATERIALS	FROM	TO	PLUGGING MATERIALS
24	17	Chlorine Shock & washed rock			
17	5	Subsoil fill			
5	4.5	Bentonite			
4.5	0	Topsoil			

7. **CONTRACTOR'S OR LANDOWNER'S CERTIFICATION:** This water well was plugged under my jurisdiction and was completed on (mo/day/year) 6/18/09 and this record is true to the best of my knowledge and belief. Kansas Water Well Contractor's License No. L. McClure. This Water Well Record was completed on (mo/day/year) 06/19/2009 under the business name of Franklin County Conservation District by (signature) [Signature]

**INSTRUCTIONS:** Use typewriter or ballpoint pen. Please press firmly and print clearly. Please fill in blanks, underline or circle the correct answers. Send top three copies to Kansas Department of Health and Environment, Bureau of Water, Geology Section, 1000 SW Jackson St., Ste. 420, Topeka, Kansas 66612-1367. Telephone: 785/296-5524. Send one to Water Well Owner and retain one for your records. Visit us at <http://www.kdheks.gov/waterwell/index.html>.

Check one: ☐ White Copy ☐ Blue Copy ☐ Pink Copy