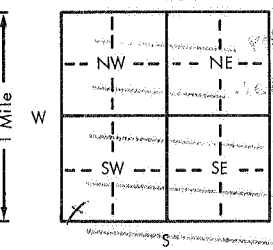
 


USE TYPEWRITER OR BALL
POINT PEN-PRESS FIRMLY,
PRINT CLEARLY.

WATER WELL RECORD
KSA 82a-1201-1215

Kansas Department of Health and
Environment-Division of Environment
(Water well Contractors)
Topeka, Kansas 66620

1. Location of well: County <u>Rush</u>		Fraction <u>SW/4SW/4SW</u> 1/4 1/4 1/4	Section number <u>24</u>	Township number <u>18</u> T S R	Range number <u>19</u> E/W
2. Distance and direction from nearest town or city: <u>3 W on Hwy</u>			3. Owner of well: <u>Berton West</u> R.R. or street: City, state, zip code: <u>Rush Center, KS</u>		
4. Locate with "X" in section below: 			Sketch map: 		
5. Type and color of material			6. Bore hole dia. <u>2 1/2</u> in. Completion date <u>6-23-76</u> Well depth <u>63</u> ft.		
Top Soil			7. Cable tool <input checked="" type="checkbox"/> Rotary <input type="checkbox"/> Driven <input type="checkbox"/> Dug <input type="checkbox"/> Hollow rod <input type="checkbox"/> Jetted <input type="checkbox"/> Bored <input type="checkbox"/> Reverse rotary		
Brown Clay			8. Use: <input type="checkbox"/> Domestic <input type="checkbox"/> Public supply <input type="checkbox"/> Industry <input checked="" type="checkbox"/> Irrigation <input type="checkbox"/> Air conditioning <input type="checkbox"/> Stock <input type="checkbox"/> Lawn <input type="checkbox"/> Oil field water <input type="checkbox"/> Other		
Sand and Clay			9. Casing: Material <u>Steel</u> Height: <u>Above</u> or below Threaded <input type="checkbox"/> Welded <input checked="" type="checkbox"/> Surface <input type="checkbox"/> in. RMP <input type="checkbox"/> PVC <input type="checkbox"/> Weight <input type="checkbox"/> lbs./ft. Dia. <u>1 1/2</u> in. to <u>6 3/4</u> ft. depth Wall Thickness: inches or Dia. <input type="checkbox"/> in. to <input type="checkbox"/> ft. depth Gauge No. <u>7</u>		
Sand and Gravel			10. Screen: Manufacturer's name <u>Deere</u> Type <u>Steel</u> Dia. <u>1 1/2</u> Slot/gauze <u>3/16</u> Length <u>20</u> Set between <u>43</u> ft. and <u>63</u> ft. Gravel pack? <input checked="" type="checkbox"/> Size range of material <u>1/2 3/4 3/8</u>		
Clay			11. Static water level: <u>29</u> ft. below land surface Date <u>5-11-76</u> <u>29</u> ft. after <u>1 1/2</u> hrs. pumping <u>300</u> g.p.m. <u> </u> ft. after <u> </u> hrs. pumping <u> </u> g.p.m. Estimated maximum yield <u>350</u> g.p.m.		
Sand and Gravel			12. Pumping level below land surfaces: Estimated maximum yield <u>350</u> g.p.m.		
Sand dark colored lot of Clay			13. Water sample submitted: <u> </u> mo./day/yr. <u> </u> Yes <u> </u> No Date <u> </u>		
Blue Clay			14. Well head completion: <u> </u> Pitless adapter <u> </u> Inches above grade		
Shale			15. Well grouted? <input checked="" type="checkbox"/> With: <u> </u> Neat cement <u> </u> Bentonite <u> </u> Concrete Depth: From <u> </u> ft. to <u>10</u> ft.		
BR 60' 4"			16. Nearest source of possible contamination: <u> </u> ft. <u> </u> Direction <u> </u> Type <u>Septic</u> Well disinfected upon completion? <u> </u> Yes <u> </u> No		
(Use a second sheet if needed)			17. Pump: <input checked="" type="checkbox"/> Not installed Manufacturer's name <u> </u> Model number <u> </u> HP <u> </u> Volts <u> </u> Length of drop pipe <u> </u> ft. capacity <u> </u> g.p.m. Type: <u> </u> Submersible <u> </u> Turbine <u> </u> Jet <u> </u> Reciprocating <u> </u> Centrifugal <u> </u> Other		
18. Elevation:		19. Remarks: <u>2016</u>		20. Water well contractor's certification: This well was drilled under my jurisdiction and this report is true to the best of my knowledge and belief. <u>Rosenkrantz - Bemis</u> <u>134</u> Business name <u>Great Bend, KS</u> License No. <u> </u> Address <u> </u> Signed <u>Fredrick Rodson</u> Date <u>9/29</u> Authorized representative	

Forward the white, blue and pink copies to the Department of Health and Environment

Form WWC-5