


1 LOCATION OF WATER WELL: County: KUSH Fraction: SW 1/4 SW 1/4 NE 1/4 Section Number: 8 Township Number: T 18 S Range Number: R 19 EW

Distance and direction from nearest town or city street address of well if located within city?

1 1/2 MILES NORTH OF NEKOMA

2 WATER WELL OWNER: CECIL JOHNSON
 RR#, St. Address, Box #: 5 TH + HARD MAVE
 City, State, ZIP Code: LACROSSE, KS
 Board of Agriculture, Division of Water Resources
 Application Number:

3 LOCATE WELL'S LOCATION WITH AN "X" IN SECTION BOX: 4 DEPTH OF COMPLETED WELL: 13'8" ft. ELEVATION:

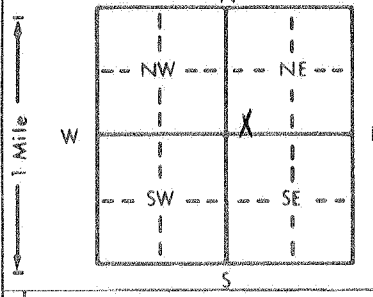

Depth(s) Groundwater Encountered 1. ft. 2. ft. 3. ft.
 WELL'S STATIC WATER LEVEL: 66' ft. below land surface measured on mo/day/yr
 Pump test data: Well water was ft. after hours pumping gpm
 Est. Yield gpm: Well water was ft. after hours pumping gpm
 Bore Hole Diameter in. to ft., and in. to ft.
 WELL WATER TO BE USED AS:
 5 Public water supply 8 Air conditioning 11 Injection well
 1 Domestic 3 Feedlot 6 Oil field water supply 9 Dewatering 12 Other (Specify below)
 2 Irrigation 4 Industrial 7 Lawn and garden only 10 Monitoring well NONE
 Was a chemical/bacteriological sample submitted to Department? Yes No If yes, mo/day/yr sample was submitted
 Water Well Disinfected? Yes No

5 TYPE OF BLANK CASING USED:
 1 Steel 3 RMP (SR) 5 Wrought iron 8 Concrete tile CASING JOINTS: Glued Clamped
 2 PVC 4 ABS 6 Asbestos-Cement 9 Other (specify below) Welded
 7 Fiberglass THREADED Threaded
 Blank casing diameter 4 1/2 in. to ft., Dia. in. to ft., Dia. in. to ft.
 Casing height above land surface in., weight lbs./ft. Wall thickness or gauge No.

TYPE OF SCREEN OR PERFORATION MATERIAL:
 1 Steel 3 Stainless steel 5 Fiberglass 7 PVC 10 Asbestos-cement
 2 Brass 4 Galvanized steel 6 Concrete tile 8 RMP (SR) 11 Other (specify) NA
 12 None used (open hole)

SCREEN OR PERFORATION OPENINGS ARE:
 1 Continuous slot 3 Mill slot 5 Gauzed wrapped 8 Saw cut 11 None (open hole)
 2 Louvered shutter 4 Key punched 6 Wire wrapped 9 Drilled holes
 7 Torch cut 10 Other (specify) NA

SCREEN-PERFORATED INTERVALS: From NA ft. to NA ft., From ft. to ft.
 From ft. to ft., From ft. to ft.
 GRAVEL PACK INTERVALS: From ft. to ft., From ft. to ft.
 From ft. to ft., From ft. to ft.

6 GROUT MATERIAL: 1 Neat cement 2 Cement grout 3 Bentonite 4 Other
 Grout Intervals: From ft. to ft., From ft. to ft., From ft. to ft.

What is the nearest source of possible contamination:
 1 Septic tank 4 Lateral lines 7 Pit privy 10 Livestock pens 14 Abandoned water well
 2 Sewer lines 5 Cess pool 8 Sewage lagoon 11 Fuel storage 15 Oil well/Gas well
 3 Watertight sewer lines 6 Seepage pit 9 Feedyard 12 Fertilizer storage 16 Other (specify below)
 13 Insecticide storage

Direction from well? How many feet?

FROM	TO	LITHOLOGIC LOG	FROM	TO	PLUGGING INTERVALS
					<u>CASED WELL</u>
			<u>13' 8"</u>	<u>6' 6"</u>	<u>13' 8" DEEP</u>
			<u>6' 6"</u>	<u>3'</u>	<u>5' 7" OF WATER</u>
			<u>3'</u>	<u>0</u>	<u>DISINFECTED</u>
					<u>WASHED SAND</u>
					<u>ENVIROPLUG</u>
					<u>CLAY + DIRT</u>

7 CONTRACTOR'S OR LANDOWNER'S CERTIFICATION: This water well was (1) constructed, (2) reconstructed, or (3) plugged under my jurisdiction and was completed on (mo/day/year) 9-20-94 and this record is true to the best of my knowledge and belief. Kansas Water Well Contractor's License No. 423 This Water Well Record was completed on (mo/day/yr) 10-12-94 under the business name of CLIVE DRILLING CO. by (signature) Clive D. Clive