


1 LOCATION OF WATER WELL: County: RUSH Fraction: SE 1/4 NE 1/4 NE 1/4 Section Number: 14 Township Number: T 18 S Range Number: R 19 E/W

Distance and direction from nearest town or city street address of well if located within city?
1 1/2 NORTH + 1/4 MI WEST OF RUSH CENTER

2 WATER WELL OWNER: JOHN KORIEL
 RR#, St. Address, Box #: _____ Board of Agriculture, Division of Water Resource
 City, State, ZIP Code: RUSH CENTER, KS Application Number: _____

3 LOCATE WELL'S LOCATION WITH AN "X" IN SECTION BOX: 4 DEPTH OF COMPLETED WELL: 17 ft. ELEVATION: _____

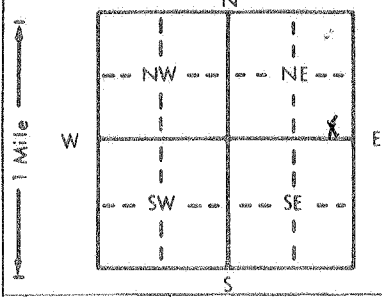

Depth(s) Groundwater Encountered 1. _____ ft. 2. _____ ft. 3. _____ ft.
 WELL'S STATIC WATER LEVEL: 6.5 ft. below land surface measured on mo/day/yr _____
 Pump test data: Well water was _____ ft. after _____ hours pumping _____ gpm
 Est. Yield _____ gpm: Well water was _____ ft. after _____ hours pumping _____ gpm
 Bore Hole Diameter: _____ in. to _____ ft., and _____ in. to _____ ft.
 WELL WATER TO BE USED AS:
 1 Domestic _____ 3 Feedlot _____ 6 Oil field water supply _____ 9 Dewatering _____ 12 Other (Specify below) _____
 2 Irrigation _____ 4 Industrial _____ 7 Lawn and garden only _____ 10 Monitoring well _____
 Was a chemical/bacteriological sample submitted to Department? Yes _____ No ; If yes, mo/day/yr sample was submitted _____
 Water Well Disinfected? Yes No _____

5 TYPE OF CASING USED:
 1 Steel _____ 3 RMP (SR) _____ 6 Asbestos-Cement _____ 9 Other (Specify below) _____
2 PVC _____ 4 ABS _____ 7 Fiberglass _____
 Blank casing diameter: 4.0 in. to _____ ft., Dia _____ in. to _____ ft., Dia _____ in. to _____ ft.
 Casing height above land surface: 36 in., weight _____ lbs./ft. Wall thickness or gauge No. _____

TYPE OF SCREEN OR PERFORATION MATERIAL:
 1 Steel _____ 3 Stainless steel _____ 5 Fiberglass _____ 8 RMP (SR) _____
 2 Brass _____ 4 Galvanized steel _____ 6 Concrete tile _____ 9 ABS _____
 10 Asbestos-cement _____ 11 Other (specify) NA
 12 None used (open hole) _____

SCREEN OR PERFORATION OPENINGS ARE:
 1 Continuous slot _____ 3 Mill slot _____ 5 Gauzed wrapped _____ 8 Saw cut _____ 11 None (open hole) _____
 2 Louvered shutter _____ 4 Key punched _____ 6 Wire wrapped _____ 9 Drilled holes _____
 7 Torch cut _____ 10 Other (specify) NA

SCREEN-PERFORATED INTERVALS: From NA ft. to NA ft., From _____ ft. to _____ ft.
 From _____ ft. to _____ ft., From _____ ft. to _____ ft.
 GRAVEL PACK INTERVALS: From _____ ft. to _____ ft., From _____ ft. to _____ ft.
 From _____ ft. to _____ ft., From _____ ft. to _____ ft.

6 GROUT MATERIAL: 1 Neat cement _____ 2 Cement grout _____ 3 Bentonite _____ 4 Other _____
 Grout Intervals: From 6 ft. to 3 ft., From _____ ft. to _____ ft., From _____ ft. to _____ ft.

What is the nearest source of possible contamination:
 1 Septic tank _____ 4 Lateral lines _____ 7 Pit privy _____ 10 Livestock pens _____ 14 Abandoned water well _____
 2 Sewer lines _____ 5 Cess pool _____ 8 Sewage lagoon _____ 11 Fuel storage _____ 15 Oil well/Gas well _____
 3 Watertight sewer lines _____ 6 Seepage pit _____ 9 Feedyard _____ 12 Fertilizer storage _____ 16 Other (specify below) _____
 13 Insecticide storage _____

Direction from well? _____ How many feet? _____

FROM	TO	LITHOLOGIC LOG	FROM	TO	PLUGGING INTERVALS
					<u>CASED WELL</u>
					<u>17 FT DEEP</u>
					<u>6 1/2 FT. TO WATER</u>
					<u>DISINFECTED</u>
			<u>6 FT</u>	<u>17 FT</u>	<u>WASHED SAND</u>
			<u>3 FT</u>	<u>6 FT</u>	<u>BENTONITE + ENVIROPLUG</u>
			<u>0</u>	<u>3 FT</u>	<u>DIRT + CLAY</u>

7 CONTRACTOR'S OR LANDOWNER'S CERTIFICATION: This water well was (1) constructed, (2) reconstructed, or (3) plugged under my jurisdiction and was completed on (mo/day/year) 9-25-94 and this record is true to the best of my knowledge and belief. Kansas Water Well Contractor's License No. 423. This Water Well Record was completed on (mo/day/yr) 10-12-94 under the business name of CLIVE DRILLING CO. by (signature) John W. Clive