


| | | | | | |
|-------------------------|-------------------------|--------------------------------------|--------------------------|---------------------------|--------------------------|
| 1 | LOCATION OF WATER WELL: | Fraction <u>SE 1/4 SW 1/4 SE 1/4</u> | Section Number <u>24</u> | Township Number <u>18</u> | Range Number <u>19 W</u> |
| County: <u>Rush 083</u> | | | | | |

Distance and direction from nearest town or city street address of well if located within city?

2 WATER WELL OWNER: John L Collins
 RR#, St. Address, Box #: RR1 Box 27 Board of Agriculture, Division of Water Resources
 City, State, ZIP Code: Rush Center, Ks, 67575 Application Number: 3209 "well No. 1"

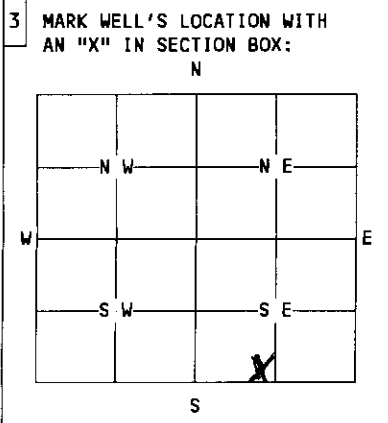

4 DEPTH OF WELL.....60'.....ft.
 WELL'S STATIC WATER LEVEL.....22'.....ft.

WELL WAS USED AS:

| | | |
|---|--|--|
| <input type="radio"/> 1 Domestic | <input type="radio"/> 5 Public Water Supply | <input type="radio"/> 9 Dewatering |
| <input checked="" type="radio"/> 2 Irrigation | <input type="radio"/> 6 Oil Field Water Supply | <input type="radio"/> 10 Monitoring Well |
| <input type="radio"/> 3 Feedlot | <input type="radio"/> 7 Lawn and Garden Only | <input type="radio"/> 11 Injection Well |
| <input type="radio"/> 4 Industrial | <input type="radio"/> 8 Air Conditioning | <input type="radio"/> 12 Other..... |

Was a chemical/bacteriological sample submitted to Department? Yes....No...
 If yes, mo/day/yr sample was submitted.....
 Water Well Disinfected: Yes.. No.....

5 TYPE OF BLANK CASING USED:

| | | | | |
|--|----------------------------------|---|---------------------------------------|---|
| <input checked="" type="radio"/> 1 Steel | <input type="radio"/> 3 RMP (SR) | <input type="radio"/> 5 Wrought | <input type="radio"/> 7 Fiberglass | <input type="radio"/> 9 Other (specify below) |
| <input type="radio"/> 2 PVC | <input type="radio"/> 4 ABS | <input type="radio"/> 6 Asbestos-Cement | <input type="radio"/> 8 Concrete Tile | |

Blank casing diameter.....18.....in. Was casing pulled? Yes..... No... If yes, how much.....
 Casing height above or below land surface.....48.....in.

6 GROUT PLUG MATERIAL: 1 Neat cement 2 Cement-grout 3 Bentonite 4 Other.....

Grout Plug Intervals: From 22' to 14', From.....ft. to.....ft., From..... to.....ft.

What is the nearest source of possible contamination:

| | | | |
|--|--|---|--|
| <input type="radio"/> 1 Septic tank | <input type="radio"/> 6 Seepage pit | <input type="radio"/> 11 Fuel storage | <input type="radio"/> 16 Other (specify below) |
| <input type="radio"/> 2 Sewer lines | <input type="radio"/> 7 Pit privy | <input type="radio"/> 12 Fertilizer storage | |
| <input type="radio"/> 3 Watertight sewer lines | <input type="radio"/> 8 Sewage lagoon | <input type="radio"/> 13 Insecticide storage | |
| <input type="radio"/> 4 Lateral lines | <input type="radio"/> 9 Feedyard | <input type="radio"/> 14 Abandoned water well | |
| <input type="radio"/> 5 Cess Pool | <input checked="" type="radio"/> 10 Livestock pens | <input type="radio"/> 15 Oil well/Gas well | |

Direction from well? ...3/8 mile West How many feet?approx. 2000'

| FROM | TO | PLUGGING MATERIALS |
|------------|------------|-------------------------|
| <u>60'</u> | <u>22'</u> | <u>Disinfected sand</u> |
| <u>22'</u> | <u>14'</u> | <u>Grout</u> |
| <u>14'</u> | <u>4'</u> | <u>Concrete</u> |
| <u>4'</u> | <u>0</u> | <u>Surface Soil</u> |
| | | |
| | | |

7 CONTRACTOR'S OR LANDOWNER'S CERTIFICATION: This water well was plugged under my jurisdiction and was completed on (mo/day/year) ...7-15-94..... and this record is true to the best of my knowledge and belief. Kansas Water Well Contractor's License No. This Water Well Record was completed on (mo/day/year) ...1-4-95..... under the business name of
 by (signature)John L. Collins.....

INSTRUCTIONS: Use typewriter or ball point pen. Please press firmly and print clearly. Please fill in blanks, underline or circle the correct answers. Send top three copies to Kansas Department of Health and Environment, Bureau of Water, Topeka, Kansas 66620-0001. Telephone: 913/296-3565. Send one to Water Well Owner and retain one for your records.