


1 LOCATION OF WATER WELL: Fraction near 1/4 center 1/4 SE 1/4 Section Number 13 Township Number T 18 S Range Number R 2 **W**

Distance and direction from nearest town or city street address of well if located within city?
6 miles north and 1 3/4 miles east of Galva, KS

2 WATER WELL OWNER: J.B. Warren
RR#, St. Address, Box # : 205 W. 2nd Board of Agriculture, Division of Water Resources
City, State, ZIP Code : Galva, KS 66739 Application Number: N/A

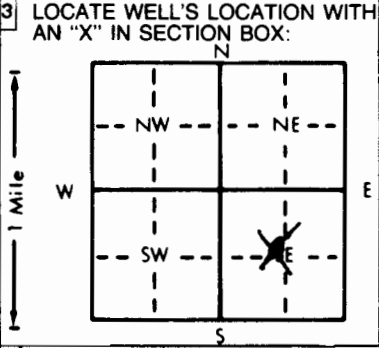

4 DEPTH OF COMPLETED WELL... 50... ft. ELEVATION:
Depth(s) Groundwater Encountered 1. ft. 2. ft. 3. ft.
WELL'S STATIC WATER LEVEL ... 8... ft. below land surface measured on mo/day/yr ... 10/14/96.
Pump test data: Well water was ft. after hours pumping gpm
Est. Yield . 2-3... gpm: Well water was ft. after hours pumping gpm
Bore Hole Diameter... 8... in. to ... 50... ft., and in. to ft.
WELL WATER TO BE USED AS: 5 Public water supply 8 Air conditioning 11 Injection well
1 Domestic 3 Feedlot 6 Oil field water supply 9 Dewatering **X** Other (Specify below)
2 Irrigation 4 Industrial 7 Lawn and garden only 10 Monitoring well **Stock Well**
Was a chemical/bacteriological sample submitted to Department? Yes..... No... **X**.....; If yes, mo/day/yr sample was submitted
Water Well Disinfected? Yes **X** No

5 TYPE OF BLANK CASING USED: 5 Wrought iron 8 Concrete tile CASING JOINTS: Glued **X** Clamped
1 Steel 3 RMP (SR) 6 Asbestos-Cement 9 Other (specify below) Welded
X PVC 4 ABS 7 Fiberglass Threaded
Blank casing diameter 5... in. to 7... ft., Dia 5... in. to 14 to 47... ft., Dia in. to ft.
Casing height above land surface 12... in., weight 2.37... lbs./ft. Wall thickness or gauge No. 214
TYPE OF SCREEN OR PERFORATION MATERIAL: **X** PVC 10 Asbestos-cement
1 Steel 3 Stainless steel 5 Fiberglass 8 RMP (SR) 11 Other (specify)
2 Brass 4 Galvanized steel 6 Concrete tile 9 ABS 12 None used (open hole)
SCREEN OR PERFORATION OPENINGS ARE: 5 Gauzed wrapped 8 Saw cut 11 None (open hole)
1 Continuous slot **X** Mill slot 6 Wire wrapped 9 Drilled holes
2 Louvered shutter 4 Key punched 7 Torch cut 10 Other (specify)
SCREEN-PERFORATED INTERVALS: From 7... ft. to 14... ft., From ft. to ft.
GRAVEL PACK INTERVALS: From 20... ft. to 50... ft., From ft. to ft.

6 GROUT MATERIAL: 1 Neat cement 2 Cement grout **X** Bentonite 4 Other
Grout Intervals: From 0... ft. to 20... ft., From ft. to ft., From ft. to ft.
What is the nearest source of possible contamination: **None within 1/2 mile** 10 Livestock pens 14 Abandoned water well
1 Septic tank 4 Lateral lines 7 Pit privy 11 Fuel storage 15 Oil well/Gas well
2 Sewer lines 5 Cess pool 8 Sewage lagoon 12 Fertilizer storage 16 Other (specify below)
3 Watertight sewer lines 6 Seepage pit 9 Feedyard 13 Insecticide storage

Direction from well? How many feet?

FROM	TO	LITHOLOGIC LOG	FROM	TO	PLUGGING INTERVALS
0	2	Top Soil			
2	7	Gray clay			
7	13	Creek Gravel			
13	50	Gray Shale			

7 CONTRACTOR'S OR LANDOWNER'S CERTIFICATION: This water well was (1) constructed, (2) reconstructed, or (3) plugged under my jurisdiction and was completed on (mo/day/year) ... 10/14/96 ... and this record is true to the best of my knowledge and belief. Kansas Water Well Contractor's License No. 138 ... This Water Well Record was completed on (mo/day/yr) ... 11/13/96 ... under the business name of **Peterson Irrigation, Inc.** by (signature) *Mike Peterson*