


1	LOCATION OF WATER WELL:	Fraction	Section Number	Township Number	Range Number
	County: Marion	$\frac{1}{4}$ SW $\frac{1}{4}$ SW $\frac{1}{4}$ NW	12	18	2 E/W

Distance and direction from nearest town or city street address of well if located within city?
3mi East + 1mi North of Durham, Ks.

2 WATER WELL OWNER: **John O'Bourney**
 RR #, St. Address, Box #: **c/o Flaming's Inc.**
 City, State, ZIP Code : **113 S. 2nd St., Marion, KS** Board of Agriculture, Division of Water Resources
 Application Number: _____

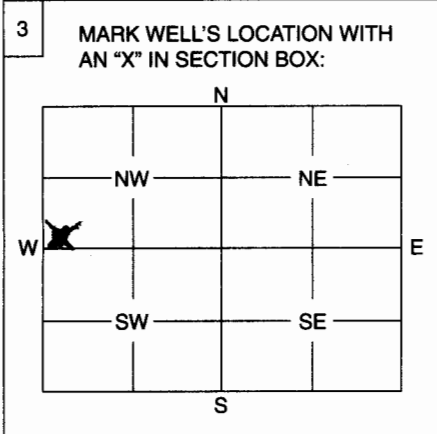

 WELL'S STATIC WATER LEVEL **19.** ft.

WELL WAS USED AS:

1 Domestic	5 Public Water Supply	9 Dewatering
2 Irrigation	6 Oil Field Water Supply	10 Monitoring Well
3 Feedlot	7 Domestic (Lawn & Garden)	11 Injection Well
4 Industrial	8 Air Conditioning	<input checked="" type="checkbox"/> Other Geo-thermal heat pump

Was a chemical / bacteriological sample submitted to Department? Yes No **X**.....
 If yes, mo/day/yr sample was submitted

Water Well Disinfected: Yes No **X**.....

5 TYPE OF BLANK CASING USED:

1 Steel	3 RMP (SR)	5 Wrought	7 Fiberglass	<input checked="" type="checkbox"/> Other (Specify below)
2 PVC	4 ABS	6 Asbestos-Cement	8 Concrete Tile	Polyethylene

Blank casing diameter **3/4** in. Was casing pulled? Yes No **X**..... If yes, how much

Casing height above or below land surface in.

6 GROUT PLUG MATERIAL: 1 Neat cement 2 Cement grout Bentonite 4 Other

Grout Plug Intervals: From **0** ft. to **300** ft., From **0** ft. to **300** ft., From to ft.

What is the nearest source of possible contamination:

<input checked="" type="checkbox"/> 1 Septic tank	6 Seepage pit	11 Fuel storage	16 Other (specify below)
2 Sewer lines	7 Pit privy	12 Fertilizer storage	
3 Watertight sewer lines	8 Sewage lagoon	13 Insecticide storage	
4 Lateral lines	9 Feedyard	14 Abandoned water well	
5 Cess pool	10 Livestock pens	15 Oil well/Gas well	

Direction from well? **North** How many feet? **150**

FROM	TO	LOG PLUGGING MATERIALS
0	2	Topsoil
2	13	Clay, tan
13	65	Shale, gray with fractures
65	95	Shale, green with limestone layers
95	300	Shale, gray and red with limestone layers

7 CONTRACTOR'S OF LANDOWNER'S CERTIFICATION: This water well was plugged under my jurisdiction and was completed on (mo/day/year) **5/1/2009** and this record is true to the best of my knowledge and belief. Kansas Water Well Contractor's License No. **138** This Water Well Record was completed on (mo/day/year) **5/14/09** under the business name of **Peterson Irrigation, Inc.**
 by (signature)

INSTRUCTIONS: Use typewriter or ball point pen. Please press firmly and print clearly. Please fill in blanks, underline or circle the correct answers. Send top three copies to Kansas Department of Health and Environment, Bureau of Water, Geology Section, 1000 SW Jackson St., Ste. 420, Topeka, Kansas 66612-1367. Telephone: 785/296-5522. Send one to Water Well Owner and retain one for your records.