


1	LOCATION OF WATER WELL:	Fraction <u>NW NW SW</u> ¼ ¼ ¼	Section <u>26</u>	Number	Township <u>T-18-S</u>	Number	Range <u>R-2-W</u>	Number E/W
County: <u>McPherson</u>								

Distance and direction from nearest town or city street address of well if located within city?  
1 east 1/2 S North of Galva

2	WATER WELL OWNER: <u>Kelly Koehn</u>	Board of Agriculture, Division of Water Resources
RR #, St. Address, Box #: <u>1941 22nd Ave</u>		Application Number:
City, State, ZIP Code: <u>Galva KS 67443</u>		

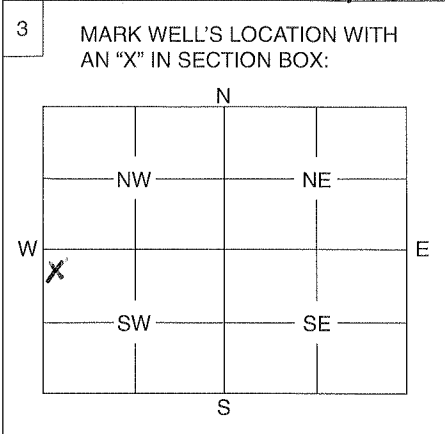

4 DEPTH OF WELL 65 ft.

WELL'S STATIC WATER LEVEL 17 ft.

WELL WAS USED AS:

<input checked="" type="checkbox"/> 1 Domestic	5 Public Water Supply	9 Dewatering
<input type="checkbox"/> 2 Irrigation	6 Oil Field Water Supply	10 Monitoring Well
<input type="checkbox"/> 3 Feedlot	7 Domestic (Lawn & Garden)	11 Injection Well
<input type="checkbox"/> 4 Industrial	8 Air Conditioning	12 Other .....

Was a chemical / bacteriological sample submitted to Department? Yes ..... No

If yes, mo/day/yr sample was submitted .....

Water Well Disinfected: Yes  No .....

5 TYPE OF BLANK CASING USED:

<input checked="" type="checkbox"/> 1 Steel	<input type="checkbox"/> 3 RMP (SR)	<input type="checkbox"/> 5 Wrought	<input type="checkbox"/> 7 Fiberglass	<input type="checkbox"/> 9 Other (Specify below)
<input checked="" type="checkbox"/> 2 PVC	<input type="checkbox"/> 4 ABS	<input type="checkbox"/> 6 Asbestos-Cement	<input type="checkbox"/> 8 Concrete Tile	

Blank casing diameter 5 in. Was casing pulled? Yes ..... No  If yes, how much .....

Casing height above or below land surface 36 in.

6 GROUT PLUG MATERIAL:  1 Neat cement  2 Cement grout  3 Bentonite  4 Other .....

Grout Plug Intervals: From 3 ft. to 0 ft., From ..... ft. to ..... ft., From ..... to ..... ft.

What is the nearest source of possible contamination:

<input type="checkbox"/> 1 Septic tank	<input type="checkbox"/> 6 Seepage pit	<input type="checkbox"/> 11 Fuel storage	<input type="checkbox"/> 16 Other (specify below)
<input type="checkbox"/> 2 Sewer lines	<input type="checkbox"/> 7 Pit privy	<input type="checkbox"/> 12 Fertilizer storage	
<input type="checkbox"/> 3 Watertight sewer lines	<input type="checkbox"/> 8 Sewage lagoon	<input type="checkbox"/> 13 Insecticide storage	
<input type="checkbox"/> 4 Lateral lines	<input type="checkbox"/> 9 Feedyard	<input type="checkbox"/> 14 Abandoned water well	
<input type="checkbox"/> 5 Cess pool	<input checked="" type="checkbox"/> 10 Livestock pens	<input type="checkbox"/> 15 Oil well/Gas well	

Direction from well? South How many feet? 300

FROM	TO	PLUGGING MATERIALS
<u>65'</u>	<u>17'</u>	<u>Course Sand</u>
<u>17'</u>	<u>3'</u>	<u>Compacted Clay</u>
<u>3'</u>	<u>0'</u>	<u>Bentonite</u>

7 CONTRACTOR'S OF LANDOWNER'S CERTIFICATION: This water well was plugged under my jurisdiction and was completed on (mo/day/year) 7-27-2011 and this record is true to the best of my knowledge and belief. Kansas Water Well Contractor's License No. N-A This Water Well Record was completed on (mo/day/year) 7-28-2011 under the business name of N-A by (signature) Kelly Koehn

INSTRUCTIONS: Use typewriter or ball point pen. Please press firmly and print clearly. Please fill in blanks, underline or circle the correct answers. Send top three copies to Kansas Department of Health and Environment, Bureau of Water, Geology Section, 1000 SW Jackson St., Ste. 420, Topeka, Kansas 66612-1367. Telephone: 785/296-5522. Send one to Water Well Owner and retain one for your records.