


**1 LOCATION OF WATER WELL:** Fraction SE 1/4 NE 1/4 SE 1/4 Section Number 27 Township Number T 18 S Range Number R 2  E  W  
 County: McPherson

**2 WELL OWNER:** Last Name: Koehn First: Tim  
 Business: Address: 1919 22nd Ave. City: Galva State: KS ZIP: 67443  
 Street or Rural Address where well is located (if unknown, distance and direction from nearest town or intersection): If at owner's address, check here:

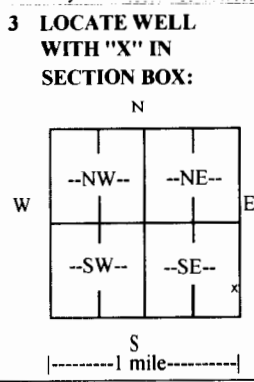

**4 DEPTH OF COMPLETED WELL:** 72 ft.  
 Depth(s) Groundwater Encountered: 1) \_\_\_\_\_ ft.  
 2) \_\_\_\_\_ ft. 3) \_\_\_\_\_ ft., or 4)  Dry Well  
**WELL'S STATIC WATER LEVEL:** 41.90 ft.  
 below land surface, measured on (mo-day-yr) 06-14-18  
 above land surface, measured on (mo-day-yr)  
 Pump test data: Well water was not checked ft.  
 after \_\_\_\_\_ hours pumping \_\_\_\_\_ gpm  
 Well water was \_\_\_\_\_ ft.  
 after \_\_\_\_\_ hours pumping \_\_\_\_\_ gpm  
 Estimated Yield: \_\_\_\_\_ gpm  
 Bore Hole Diameter: 9 in. to 72 ft. and \_\_\_\_\_ in. to \_\_\_\_\_ ft.

**5 Latitude:** 38.45216 (decimal degrees)  
**Longitude:** -97.519767 (decimal degrees)  
 Horizontal Datum:  WGS 84  NAD 83  NAD 27  
 Source for Latitude/Longitude:  
 GPS (unit make/model: \_\_\_\_\_) (WAAS enabled?  Yes  No)  
 Land Survey  Topographic Map  
 Online Mapper:

**6 Elevation:** Unknown ft.  Ground Level  TOC  
 Source:  Land Survey  GPS  Topographic Map  
 Other \_\_\_\_\_

- 7 WELL WATER TO BE USED AS:**
- 1. Domestic:  Household  Lawn & Garden  Livestock
  - 2.  Irrigation
  - 3.  Feedlot
  - 4.  Industrial
  - 5.  Public Water Supply: well ID
  - 6.  Dewatering: how many wells?
  - 7.  Aquifer Recharge: well ID
  - 8.  Monitoring: well ID
  - 9. Environmental Remediation: well ID  
 Air Sparge  Soil Vapor Extraction  
 Recovery  Injection
  - 10.  Oil Field Water Supply: lease
  - 11. Test Hole: well ID  
 Cased  Uncased  Geotechnical
  - 12. Geothermal: how many bores?  
 a) Closed Loop  Horizontal  Vertical  
 b) Open Loop  Surface Discharge  Inj. of Water
  - 13.  Other (specify): \_\_\_\_\_

**Was a chemical/bacteriological sample submitted to KDHE?**  Yes  No If yes, date sample was submitted:  
 Water well disinfected?  Yes  No

**8 TYPE OF CASING USED:**  Steel  PVC CASING JOINTS:  Glued  Clamped  Welded  Threaded  Other  
 Casing diameter 5 in. to 40 ft., Diameter 5 in. to 70 ft., Diameter \_\_\_\_\_ in. to \_\_\_\_\_ ft.  
 Casing height above land surface 24 in. Weight 2.36 lbs./ft. Wall thickness or gauge No. .214  
**TYPE OF SCREEN OR PERFORATION MATERIAL:**  
 Steel  Stainless Steel  Fiberglass  PVC  Other (Specify) \_\_\_\_\_  
 Brass  Galvanized Steel  Concrete tile  None used (open hole)  
**SCREEN OR PERFORATION OPENINGS ARE:**  
 Continuous Slot  Mill Slot  Gauze Wrapped  Torch Cut  Drilled Holes  Other (Specify) \_\_\_\_\_  
 Louvered Shutter  Key Punched  Wire Wrapped  Saw Cut  None (Open Hole)  
**SCREEN-PERFORATED INTERVALS:** From 40 ft. to 60 ft., From \_\_\_\_\_ ft. to \_\_\_\_\_ ft.  
**GRAVEL PACK INTERVALS:** From 24 ft. to 72 ft., From \_\_\_\_\_ ft. to \_\_\_\_\_ ft.

**9 GROUT MATERIAL:**  Neat cement  Cement grout  Bentonite  Other  
 Grout Intervals: From 0 ft. to 24 ft., From \_\_\_\_\_ ft. to \_\_\_\_\_ ft., From \_\_\_\_\_ ft. to \_\_\_\_\_ ft.

**Nearest source of possible contamination:**  
 Septic Tank  Lateral Lines  Pit Privy  Livestock Pens  Insecticide Storage  
 Sewer Lines  Cess Pool  Sewage Lagoon  Fuel Storage  Abandoned Water Well  
 Watertight Sewer Lines  Seepage Pit  Feedyard  Fertilizer Storage  Oil Well/Gas Well  
 Other (Specify) \_\_\_\_\_ None Known  
 Direction from well? \_\_\_\_\_ Distance from well? \_\_\_\_\_ ft.

10 FROM	TO	LITHOLOGIC LOG	FROM	TO	LITHO. LOG (cont.) or PLUGGING INTERVALS
0	3	Topsoil			
3	11	Clay, gray & brown			
11	43	Clay, white, with cemented sand			
43	59	Clay, tan, white with gravel, medium to fine			
59	61	Weathered shale			
61	73	Shale, gray			

**Notes:**

**11 CONTRACTOR'S OR LANDOWNER'S CERTIFICATION:** This water well was  constructed,  reconstructed, or  plugged under my jurisdiction and was completed on (mo-day-year) 06-14-18 and this record is true to the best of my knowledge and belief.  
 Kansas Water Well Contractor's License No. 185 This Water Well Record was completed on (mo-day-year) 06-18-18  
 under the business name of Clarke Well & Equipment, Inc. Signature \_\_\_\_\_