

WATER WELL RECORD Form WWC-5 KSA 82a-1212


1 LOCATION OF WATER WELL: Fraction SE 1/4 SW 1/4 SE 1/4 Section Number 20 Township Number T 18 S Range Number R 20 EW

Distance and direction from nearest town or city street address of well if located within city?

S of railroad tracks at King St., Alexander

2 WATER WELL OWNER: Farmer's Coop Oil & Supply Co. RR#, St. Address, Box # : PO Box 195 City, State, ZIP Code : Rush Center, Kansas 67575 Board of Agriculture, Division of Water Resources Application Number:

3 LOCATE WELL'S LOCATION WITH AN "X" IN SECTION BOX:

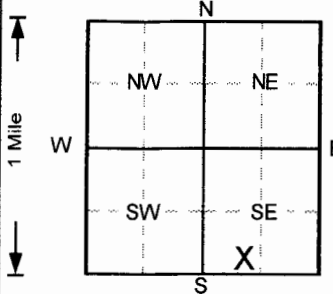

4 DEPTH OF COMPLETED WELL .45 ft. ELEVATION: Depth(s) Groundwater Encountered 1. ft. 2. ft. 3. ft. WELL'S STATIC WATER LEVEL ft. below land surface measured on mo/day/yr Pump test data: Well water was .NA. ft. after hours pumping gpm Est. Yield .NA. gpm: Well water was ft. after hours pumping gpm Bore Hole Diameter .8. in. to .45. ft. and in. to ft. WELL WATER TO BE USED AS: 5 Public water supply 8 Air conditioning 11 Injection well 1 Domestic 3 Feedlot 6 Oil field water supply 9 Dewatering (12) Other (Specify below) 2 Irrigation 4 Industrial 7 Lawn and garden only 10 Monitoring well Air sparge Was a chemical/bacteriological sample submitted to Department? Yes. No (checked); If yes, mo/day/yr sample was submitted Water Well Disinfected? Yes No (checked)

5 TYPE OF BLANK CASING USED: 1 Steel 2 (2) PVC 3 RMP (SR) 4 ABS 5 Wrought iron 6 Asbestos-Cement 7 Fiberglass 8 Concrete tile 9 Other (specify below) CASING JOINTS: Glued Clamped Welded Threaded (checked) Blank casing diameter .2. in. to .42.5. ft. Dia. in. to ft. Dia. in. to ft. Casing height above land surface in., weight lbs./ft. Wall thickness or gauge No. .Sch. 40 TYPE OF SCREEN OR PERFORATION MATERIAL: 1 Steel 2 Brass 3 Stainless steel 4 Galvanized steel 5 Fiberglass 6 Concrete tile 7 (7) PVC 8 RMP (SR) 9 ABS 10 Asbestos-cement 11 Other (specify) 12 None used (open hole) SCREEN OR PERFORATION OPENINGS ARE: 1 Continuous slot 2 Louvered shutter 3 (3) Mill slot 4 Key punched 5 Gauzed wrapped 6 Wire wrapped 7 Torch cut 8 Saw cut 9 Drilled holes 10 Other (specify) 11 None (open hole) SCREEN-PERFORATED INTERVALS: From .42.5. ft. to .45. ft. From ft. to ft. From ft. to ft. GRAVEL PACK INTERVALS: From .40. ft. to .45. ft. From ft. to ft. From ft. to ft.

6 GROUT MATERIAL: 1 Neat cement 2 Cement grout 3 (3) Bentonite 4 Other Grout Intervals: From .3. ft. to .40. ft. From ft. to ft. From ft. to ft. What is the nearest source of possible contamination: 1 Septic tank 2 Sewer lines 3 Watertight sewer lines 4 Lateral lines 5 Cess pool 6 Seepage pit 7 Pit privy 8 Sewage lagoon 9 Feedyard 10 Livestock pens 11 Fuel storage 12 Fertilizer storage 13 Insecticide storage 14 Abandoned water well 15 Oil well/Gas well 16 Other (specify below) Direction from well? How many feet?

FROM	TO	LITHOLOGIC LOG	FROM	TO	PLUGGING INTERVALS
0	1	Road Gravel,			
1	2	Silt, clayey, Dark Brown			
2	10	Clay, sl. silty, Med. Brown			
10	18	Clay, silty, Med. Brown			
18	27	Clay, sl. silty, w/caliche, Med. Brown			
27	32	Silt, clayey, Tan			
32	37	Sand (f), v. silty to clayey, Lt. Gray			
37	45	Gravel, w/m-c sand, sl. silty, Lt. Gray			
					AS9, Flushmount

7 CONTRACTOR'S OR LANDOWNER'S CERTIFICATION: This water well was (1) constructed, (2) reconstructed, or (3) plugged under my jurisdiction and was completed on (mo/day/year) .2/18/2010 and this record is true to the best of my knowledge and belief. Kansas Water Well Contractor's License No. .527. This Water Well Record was completed on (mo/day/yr) .2/26/2010 under the business name of GeoCore, Inc. by (signature)

INSTRUCTIONS: Use typewriter or ball point pen. PLEASE PRESS FIRMLY and PRINT clearly. Please fill in blanks, underline or circle the correct answers. Send top three copies to Kansas Department of Health and Environment, Bureau of Water, Topeka, Kansas 66620-0001. Telephone: 913-296-5545. Send one to WATER WELL OWNER and retain one for your records.

OFFICE USE ONLY
T
R
EW
SEC
1/4
1/4