


1 LOCATION OF WATER WELL:										Fraction		Section Number		Township Number		Range Number	
County: Rush										NE ¼ SW ¼ SW ¼		20		T 18 S		R 20 E/W	

K96 Hwy & Whippet Ave, Alexander

RP#, St. Address, Box # : PO Box 195
City, State, ZIP Code : Rush Center, KS 67575

Board of Agriculture, Division of Water Resources
Application Number:

4 DEPTH OF COMPLETED WELL 44.5 ft. ELEVATION:

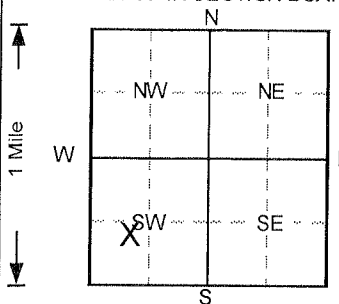

WELL'S STATIC WATER LEVEL ft. below land surface measured on mo/day/yr

Est. Yield . . . **NA** . . . gpm: Well water was ft. after hours pumping gpm

WELL WATER TO BE USED AS: 5 Public water supply 8 Air conditioning 11 Injection well

2 Irrigation 4 Industrial 7 Lawn and garden only 10 Monitoring well

submitted Water Well Disinfected? Yes No ☒

5 Wrought iron 8 Concrete tile CASING JOINTS: Glued Clamped

2 PVC 4 ABS 7 Fiberglass Threaded. ✓

Casing height above land surface in., weight lbs./ft. Wall thickness or gauge No. **Sch. 40**

7 PVC 10 Asbestos-cement

2 Brass	4 Galvanized steel	6 Concrete tile	9 ABS	12 None used (open hole)
---------	--------------------	-----------------	-------	--------------------------

5 Gauzed wrapped 8 Saw cut 11 None (open hole)

2 Louvered shutter 4 Key punched 7 Torch cut 10 Other (specify)

From ft. to ft., From ft. to ft.

From ft. to ft. From ft. to ft.

6	GRAOUT MATERIAL:	1 Neat cement	2 Cement grout	3 Bentonite	4 Other
---	------------------	---------------	----------------	-------------	---------

6 GROUT MATERIAL: 1 Neat cement 2 Cement grout 3 Bentonite 4 Other

Grout Intervals: From 3 ft. to 35 ft., From 35 ft. to 38 ft., From ft. to ft.

What is the nearest source of possible contamination:

1 Septic tank	4 Lateral lines	7 Pit privy	11 Fuel storage	15 Oil well/Gas well
---------------	-----------------	-------------	-----------------	----------------------

2 Sewer lines	5 Cess pool	8 Sewage lagoon	12 Fertilizer storage	16 Other (specify below)
---------------	-------------	-----------------	-----------------------	--------------------------

3 Watertight sewer lines	6 Seepage pit	9 Feedyard	12 Fertilizer storage	15 Other (specify below)
4	7	10	13 Insecticide storage	

Direction from well?

How many feet?

[illegible]

Kansas Water Well Contractor's License No. 527 This Water Well Record was completed on (mo/day/yr) 6/20/2011

by (signature) *Dale Bolt*

INSTRUCTIONS: Use typewriter or ball point pen. PLEASE PRESS FIRMLY and PRINT clearly. Please fill in blanks, underline or circle the correct answers. Send top three copies to Kansas Department of Health and Environment, Bureau of Water, Topeka, Kansas 66620-0001. Telephone: 913-296-5545. Send one to WATER WELL OWNER and retain one for your records.