


1] LOCATION OF WATER WELL:		Fraction	Section Number		Township Number		Range Number	
County:	Rush	NE ¼	SW ¼	SW ¼	20	T 18 S	R 20	EW

K96 Hwy & Whippet Ave, Alexander

RR#, St. Address, Box # PO Box 195
City, State, ZIP Code Rush Center, KS 67575

Board of Agriculture, Division of Water Resources
Application Number:

4 DEPTH OF COMPLETED WELL 44.5 ft. ELEVATION:

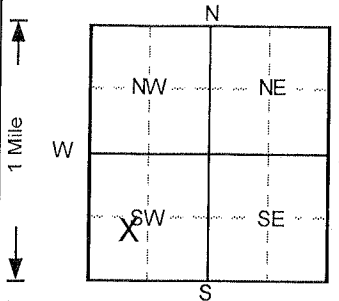

Depth(s) Groundwater Encountered 1. ft. 2. ft. 3. ft.

WELL'S STATIC WATER LEVEL ft. below land surface measured on mo/day/yr

Pump test data: Well water was NA ft. after NA hours pumping NA gpm.

Est. Yield **NA** gpm: Well water was _____ ft. after _____ hours pumping _____ gpm

Bore Hole Diameter **8** in. to **44.5** ft. and _____ in. to _____ ft.

WELL WATER TO BE USED AS: 5. Public water supply 6. Air conditioning 11. ☐ " " " "

WELL WATER TO BE USED AS:

5 Public water supply	8 Air conditioning	11 Injection well

1 Domestic 3 Feedlot 6 Oil field water supply 9 Dewatering 12 Other (Specify below)

2 Irrigation 4 Industrial 7 Lawn and garden only 10 Monitoring well

Was a chemical/bacteriological sample submitted to Department? Yes.....No ☒ ..; If yes, mo/day/yr sample was submitted

submitted _____ Water Well Disinfected? Yes _____ No ☒

5 Wrought iron 8 Concrete tile CASING JOINTS: Glued Clamped

R) 6 Asbestos-Cement 9 Other (specify below) Welded

7 Fiberglass Threaded. ✓

in. to 40 ft. Dia 2 in. to 44.5 ft. Dia _____ in. to _____ ft.

..... in., weight lbs./ft. Wall thickness or gauge No. **Sch. 40**

7 PVC 10 Asbestos-cement

steel	5 Fiberglass	8 RMP (SR)	10 Asbestos-cement
			11 Other (specify)

steel	5 Fiberglass	9 RMR (SR)	11 Other (specify)
ed steel	6 Concrete tile	8 ABS	12 None used (open hole)

GS ABF: 5 Gauzed wrapped 8 Saw cut 11 None (open hole)

5 Gauzed wrapped	8 Saw cut	11 None (open hole)
6 Wire wrapped	9 Drilled holes	

6 Wire wrapped	9 Drilled holes
7 Torch cut	10 Other (specify)

From ft. to ft., From ft. to ft.

6 GROUT MATERIAL: 1 Neat cement 2 Cement grout 3 Bentonite 4 Other

Grout Intervals: From 3 ft. to 35 ft. From 35 ft. to 38 ft. From ft. to ft.

What is the nearest source of possible contamination: 10. Livestock pens 14. Abandoned water well


1 Septic tank	4 Lateral lines	7 Pit privy	11 Fuel storage	15 Oil well/Gas well
2 Sewer lines	5 Cess pool	8 Sewage lagoon	12 Fertilizer storage	16 Oil/water separator

2 Sewer lines	5 Cess pool	8 Sewage lagoon	12 Fertilizer storage	16 Other (specify below)
3 Watertight sewer lines	6 Seepage pit	9 Foodyard	13 Insecticide storage	

13 Insecticide storage
How many feet?

Direction from well?			How many feet?		
FROM	TO	LITHOLOGIC LOG	FROM	TO	PLUGGING INTERVALS

[illegible]

7 CONTRACTOR'S OR LANDOWNER'S CERTIFICATION: This water well was (1) constructed, (2) reconstructed, or (3) plugged under my jurisdiction and was completed on (mo/day/year) 5/25/2011 and this record is true to the best of my knowledge and belief.
Kansas Water Well Contractor's License No. 527 This Water Well Record was completed on (mo/day/yr) 6/20/2011
under the business name of GeoCore, Inc. by (signature) [Signature]

INSTRUCTIONS: Use typewriter or ball point pen. PLEASE PRESS FIRMLY and PRINT clearly. Please fill in blanks, underline or circle the correct answers. Send top three copies to Kansas Department of Health and Environment, Bureau of Water, Topeka, Kansas 66620-0001. Telephone: 913-296-5545. Send one to WATER WELL OWNER and retain one for your records.