


1) LOCATION OF WATER WELL: County: Rush Fraction: NE 1/4 NW 1/4 SW 1/4 Section Number: 26 Township Number: T 18 S Range Number: R 20 EW

Distance and direction from nearest town or city street address of well if located within city?

Alexander east 1/4 south center line on Dam site #19 wet walnut water shed

2) WATER WELL OWNER: B.S.B. Construction
 RR#, St. Address, Box #: RT. 1 Box 44
 City, State, ZIP Code: Curtis Nebraska 69025
 Board of Agriculture, Division of Water Resources
 Application Number:

3) LOCATE WELL'S LOCATION WITH AN "X" IN SECTION BOX:

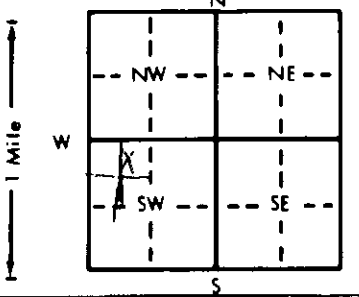

4) DEPTH OF COMPLETED WELLS: 25' ft. ELEVATION: Battery of 2 wells

Depth(s) Groundwater Encountered: 1. 12' ft. 2. 12' ft. 3. 12' ft.
 WELL'S STATIC WATER LEVEL: 12' ft. below land surface measured on 8-20-91 mo/day/yr
 Pump test data: Well water was 70 gpm. Well water was 8" in. to 2.5' ft. after 8 hours pumping
 Est. Yield: 70 gpm. Well water was 8" in. to 2.5' ft. after 8 hours pumping
 Bore Hole Diameter: 8" in. to 2.5' ft., and 8" in. to 2.5' ft.
 WELL WATER TO BE USED AS:
 1 Domestic 70 gpm. 3 Feedlot 6 Oil field water supply Dewatering 11 Injection well
 2 Irrigation 4 Industrial 7 Lawn and garden only 10 Observation well 12 Other (Specify below)
 Was a chemical/bacteriological sample submitted to Department? Yes No X. If yes, mo/day/yr sample was submitted No X
 Water Well Disinfected? Yes No X

5) TYPE OF BLANK CASING USED:
 1 Steel 2 PVC 3 RMP (SR) 4 ABS 5 Wrought iron 6 Asbestos-Cement 7 Fiberglass 8 Concrete tile 9 Other (specify below) CASING JOINTS: Glued Clamped Welded Threaded

Blank casing diameter: 5 in. to 15 ft. Dia. 5 in. to 15 ft. Dia. 5 in. to 15 ft. Dia.
 Casing height above land surface: 2' ft. weight 200 lbs./ft. Wall thickness or gauge No. 200

TYPE OF SCREEN OR PERFORATION MATERIAL:
 1 Steel 2 Brass 3 Stainless steel 4 Galvanized steel 5 Fiberglass 6 Concrete tile 7 PVC 8 RMP (SR) 9 ABS 10 Asbestos-cement 11 Other (specify) 12 None used (open hole)

SCREEN OR PERFORATION OPENINGS ARE:
 1 Continuous slot 2 Louvered shutter 3 Mill slot 4 Key punched 5 Gauzed wrapped 6 Wire wrapped 7 Torch cut 8 Saw cut 9 Drilled holes 10 Other (specify) 11 None (open hole)

SCREEN-PERFORATED INTERVALS: From 15 ft. to 25' ft. From 15 ft. to 25' ft. From 15 ft. to 25' ft.
 GRAVEL PACK INTERVALS: From 12 ft. to 25' ft. From 12 ft. to 25' ft. From 12 ft. to 25' ft.

6) GROUT MATERIAL: 1 Neat cement 2 Cement grout 3 Bentonite 4 Other
 Grout intervals: From 0 ft. to 12 ft. From 0 ft. to 12 ft. From 0 ft. to 12 ft.

What is the nearest source of possible contamination:
 1 Septic tank 2 Sewer lines 3 Watertight sewer lines 4 Lateral lines 5 Cess pool 6 Seepage pit 7 Pit privy 8 Sewage lagoon 9 Feedyard 10 Livestock pens 11 Fuel storage 12 Fertilizer storage 13 Insecticide storage 14 Abandoned water well 15 Oil well/Gas well 16 Other (specify below) Cover Trench

Direction from well? Center line of Dam How many feet? 200 ft apart

FROM	TO	LITHOLOGIC LOG	FROM	TO	LITHOLOGIC LOG
0	12	soil			
12	23	coarse sand			
23	25	shale			
Battery of 2 wells 200 ft apart					

7) CONTRACTOR'S OR LANDOWNER'S CERTIFICATION: This water well was (1) constructed (2) reconstructed, or (3) plugged under my jurisdiction and was completed on (mo/day/year) 8-20-91 and this record is true to the best of my knowledge and belief. Kansas Water Well Contractor's License No. 489 This Water Well Record was completed on (mo/day/yr) 6-15-92 under the business name of Aqua Drilling Inc by (signature) M. Little