


1 LOCATION OF WATER WELL: Fraction SE 1/4 SW 1/4 SE 1/4 Section Number 20 Township Number T 18 S Range Number R 20 EW
 County: Rush

Distance and direction from nearest town or city street address of well if located within city?
96 Highway, Alexander

2 WATER WELL OWNER: Farmers Coop Oil & Supply
 RR#, St. Address, Box #: 96 Highway Board of Agriculture, Division of Water Resources
 City, State, ZIP Code: Alexander KS 67513 Application Number:

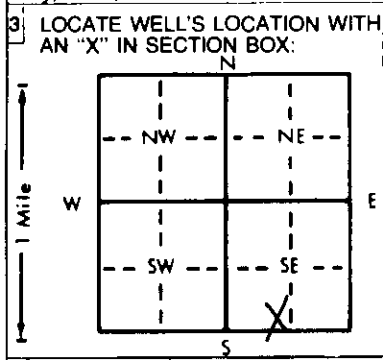

4 DEPTH OF COMPLETED WELL 40.0 ft. ELEVATION:
 Depth(s) Groundwater Encountered 1. 34.0 ft. 2. _____ ft. 3. _____ ft.
 WELL'S STATIC WATER LEVEL 31.56 ft. below land surface measured on mo/day/yr 1-27-93
 Pump test data: Well water was _____ ft. after _____ hours pumping _____ gpm
 Est. Yield _____ gpm Well water was _____ ft. after _____ hours pumping _____ gpm
 Bore Hole Diameter 8 in. to _____ ft., and _____ in. to _____ ft.
 WELL WATER TO BE USED AS:
 1 Domestic 2 Irrigation 3 Feedlot 4 Industrial 5 Public water supply 6 Oil field water supply 7 Lawn and garden only 8 Air conditioning 9 Dewatering 10 Monitoring well 11 Injection well 12 Other (Specify below)
 Was a chemical/bacteriological sample submitted to Department? Yes _____ No X If yes, mo/day/yr sample was submitted _____
 Water Well Disinfected? Yes _____ No X

5 TYPE OF BLANK CASING USED:
 1 Steel 2 PVC 3 RMP (SR) 4 ABS 5 Wrought iron 6 Asbestos-Cement 7 Fiberglass 8 Concrete tile 9 Other (specify below) CASING JOINTS: Glued _____ Clamped _____ Welded _____ Threaded Flush
 Blank casing diameter 2 in. to _____ ft., Dia _____ in. to _____ ft., Dia _____ in. to _____ ft.
 Casing height above land surface Flush in., weight 703 lbs./ft. Wall thickness or gauge No. 154
 TYPE OF SCREEN OR PERFORATION MATERIAL:
 1 Steel 2 Brass 3 Stainless steel 4 Galvanized steel 5 Fiberglass 6 Concrete tile 7 PVC 8 RMP (SR) 9 ABS 10 Asbestos-cement 11 Other (specify) 12 None used (open hole)
 SCREEN OR PERFORATION OPENINGS ARE:
 1 Continuous slot 2 Louvered shutter 3 Mill slot 4 Key punched 5 Gauzed wrapped 6 Wire wrapped 7 Torch cut 8 Saw cut 9 Drilled holes 10 Other (specify) 11 None (open hole)
 SCREEN-PERFORATED INTERVALS: From 25.0 ft. to 40.0 ft. From _____ ft. to _____ ft.
 GRAVEL PACK INTERVALS: From 26.0 ft. to 40.0 ft. From _____ ft. to _____ ft.

6 GROUT MATERIAL: 1 Neat cement 2 Cement grout 3 Bentonite 4 Other _____
 Grout intervals: From 26.0 ft. to 1.0 ft. From _____ ft. to _____ ft. From _____ ft. to _____ ft.
 What is the nearest source of possible contamination:
 1 Septic tank 2 Sewer lines 3 Watertight sewer lines 4 Lateral lines 5 Cess pool 6 Seepage pit 7 Pit privy 8 Sewage lagoon 9 Feedyard 10 Livestock pens 11 Fuel storage 12 Fertilizer storage 13 Insecticide storage 14 Abandoned water well 15 Oil well/Gas well 16 Other (specify below)
 Direction from well? East How many feet? 3

FROM	TO	LITHOLOGIC LOG	FROM	TO	PLUGGING INTERVALS
0.0	4.0	Fill, Clay			
4.0	8.5	Clay, Sandy, silty			
8.5	23.5	Clay, silty, sandy			
23.5	28.5	Clay, silty			
28.5	33.5	Clay, silty, slightly sandy			
33.5	38.5	Sandy, very fine to medium grain, moderate sorted			
38.5	40.0	Sand, coarse to medium grain, moderate to well sorted			
Flush mount waiver granted on 12-10-92 for Farmers Coop Oil & Supply; KDHE 01083598					

7 CONTRACTOR'S OR LANDOWNER'S CERTIFICATION: This water well was (1) constructed, (2) reconstructed, or (3) plugged under my jurisdiction and was completed on (mo/day/year) 1-27-93 and this record is true to the best of my knowledge and belief. Kansas Water Well Contractor's License No. 531 This Water Well Record was completed on (mo/day/yr) 1-28-93 under the business name of GST by (signature) Alison Irwin

OFFICE USE ONLY
T
R
EW
SEC.
1/4
1/4
1/4