


1) LOCATION OF WATER WELL: County: Rush Fraction: NE 1/4 NW 1/4 SW 1/4 Section Number: 26 Township Number: T 18 S Range Number: R 20 EW

Distance and direction from nearest town or city street address of well if located within city?
Alexander east 1/4 south center line on Dam site #19 wet walnut water shed

2) WATER WELL OWNER: B.S.B. Construction
 RR#, St. Address, Box #: RT. 1 Box 44
 City, State, ZIP Code: Curtis Nebraska 69025

Board of Agriculture, Division of Water Resources
 Application Number: _____

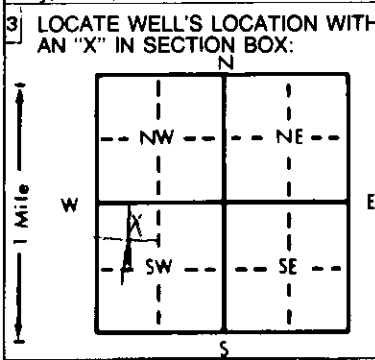

4) DEPTH OF COMPLETED WELLS: 25' ft. ELEVATION: Battery of 2 wells

Depth(s) Groundwater Encountered: 1. 12' ft. 2. _____ ft. 3. _____ ft.

WELL'S STATIC WATER LEVEL: 12' ft. below land surface measured on mo/day/yr: 8-20-91

Pump test data: Well water was _____ ft. after _____ hours pumping _____ gpm

Est. Yield: 70 gpm; Well water was _____ ft. after _____ hours pumping _____ gpm

Bore Hole Diameter: 8" in. to 2.5' ft., and _____ in. to _____ ft.

WELL WATER TO BE USED AS:

5 Public water supply	8 Air conditioning	11 Injection well
1 Domestic	3 Feedlot	6 Oil field water supply
2 Irrigation	4 Industrial	7 Lawn and garden only
		10 Observation well

WATER CONDITIONING: Dewatering

12 Other (Specify below) _____

Was a chemical/bacteriological sample submitted to Department? Yes _____ No: X If yes, mo/day/yr sample was submitted _____

Water Well Disinfected? Yes _____ No: X

5) TYPE OF BLANK CASING USED:

1 Steel	3 RMP (SR)	5 Wrought iron	8 Concrete tile
<u>2 PVC</u>	4 ABS	6 Asbestos-Cement	9 Other (specify below)
		7 Fiberglass	

CASING JOINTS: Glued Clamped _____
 Welded _____
 Threaded _____

Blank casing diameter: 5 in. to 1.5 ft. Dia. _____ in. to _____ ft. Dia. _____ in. to _____ ft.

Casing height above land surface: 2' ft. weight _____ lbs./ft. Wall thickness or gauge No. 200

TYPE OF SCREEN OR PERFORATION MATERIAL:

1 Steel	3 Stainless steel	5 Fiberglass	8 RMP (SR)	10 Asbestos-cement
2 Brass	4 Galvanized steel	6 Concrete tile	9 ABS	11 Other (specify)
				12 None used (open hole)

SCREEN OR PERFORATION OPENINGS ARE:

1 Continuous slot	3 Mill slot	5 Gauzed wrapped	<u>8 Saw cut</u>	11 None (open hole)
2 Louvered shutter	4 Key punched	6 Wire wrapped	9 Drilled holes	
		7 Torch cut	10 Other (specify)	

SCREEN-PERFORATED INTERVALS: From 15 ft. to 25' ft. From _____ ft. to _____ ft.

GRAVEL PACK INTERVALS: From 12 ft. to 25 ft. From _____ ft. to _____ ft.

6) GROUT MATERIAL: 1 Neat cement 2 Cement grout 3 Bentonite 4 Other _____

Grout intervals: From 0 ft. to 12 ft. From _____ ft. to _____ ft.

What is the nearest source of possible contamination:

1 Septic tank	4 Lateral lines	7 Pit privy	10 Livestock pens	14 Abandoned water well
2 Sewer lines	5 Cess pool	8 Sewage lagoon	11 Fuel storage	15 Oil well/Gas well
3 Watertight sewer lines	6 Seepage pit	9 Feedyard	12 Fertilizer storage	16 Other (specify below)
			13 Insecticide storage	<u>Cover Trench</u>

Direction from well? _____ How many feet? Center line of Dam

FROM	TO	LITHOLOGIC LOG	FROM	TO	LITHOLOGIC LOG
0	12	soil			
12	23	coarse sand			
23	25	shale			
Battery of 2 wells 200 ft apart.					

7) CONTRACTOR'S OR LANDOWNER'S CERTIFICATION: This water well was (1) constructed (2) reconstructed, or (3) plugged under my jurisdiction and was completed on (mo/day/year) 8-20-91 and this record is true to the best of my knowledge and belief. Kansas Water Well Contractor's License No. 489 This Water Well Record was completed on (mo/day/yr) 6-15-92

under the business name of Aqua Drilling Inc by (signature) M. Little

OFFICE USE ONLY