


WATER WELL RECORD Form WWC-5 KSA 82a-1212

1 LOCATION OF WATER WELL: County: Ness Fraction NE 1/4 NW 1/4 NW 1/4 Section Number 31 Township Number T 18 S Range Number R 21 E/W

Distance and direction from nearest town or city street address of well if located within city? 204 West Washington - Bazine, Kansas

2 WATER WELL OWNER: Cooperative Grain and Supply Co. RR#, St. Address, Box #: P.O. Box 8 City, State, ZIP Code: Bazine, Kansas 67516 Board of Agriculture, Division of Water Resources Application Number:

3 LOCATE WELL'S LOCATION WITH AN "X" IN SECTION BOX:

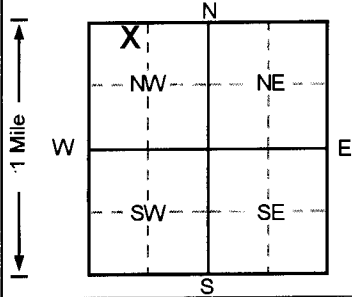

4 DEPTH OF COMPLETED WELL: 40 ft. ELEVATION: 2140.65. Depth(s) Groundwater Encountered: 1. 35 ft. 2. 35.32 ft. 3. 35.32 ft. WELL'S STATIC WATER LEVEL: 35.32 ft. below land surface measured on mo/day/yr 7/31/96. Pump test data: Well water was NA ft. after NA hours pumping NA gpm. Est. Yield NA gpm. Well water was NA ft. after NA hours pumping NA gpm. Bore Hole Diameter: 8 in. to 40 ft., and in. to ft. WELL WATER TO BE USED AS: 5 Public water supply 8 Air conditioning 11 Injection well 1 Domestic 3 Feedlot 6 Oil field water supply 9 Dewatering 12 Other (Specify below) 2 Irrigation 4 Industrial 7 Lawn and garden only 10 Monitoring well. Was a chemical/bacteriological sample submitted to Department? Yes No checked. If yes, mo/day/yr sample was submitted. Water Well Disinfected? Yes No checked.

5 TYPE OF BLANK CASING USED: 1 Steel 2 PVC checked 3 RMP (SR) 4 ABS 5 Wrought iron 6 Asbestos-Cement 7 Fiberglass 8 Concrete tile 9 Other (specify below) CASING JOINTS: Glued Clamped Welded Threaded checked. Blank casing diameter: 2 in. to 25 ft. Dia. in. to ft. Dia. in. to ft. Casing height above land surface: -2.88 in., weight lbs./ft. Wall thickness or gauge No. Sch. 40.

TYPE OF SCREEN OR PERFORATION MATERIAL: 1 Steel 2 Brass 3 Stainless steel 4 Galvanized steel 5 Fiberglass 6 Concrete tile 7 PVC checked 8 RMP (SR) 9 ABS 10 Asbestos-cement 11 Other (specify) 12 None used (open hole).

SCREEN OR PERFORATION OPENINGS ARE: 1 Continuous slot 2 Louvered shutter 3 Mill slot checked 4 Key punched 5 Gauzed wrapped 6 Wire wrapped 7 Torch cut 8 Saw cut 9 Drilled holes 10 Other (specify) 11 None (open hole).

SCREEN-PERFORATED INTERVALS: From 25 ft. to 40 ft. From ft. to ft. From ft. to ft. GRAVEL PACK INTERVALS: From 23 ft. to 40 ft. From ft. to ft. From ft. to ft.

6 GROUT MATERIAL: 1 Neat cement 2 Cement grout checked 3 Bentonite 4 Other. Grout Intervals: From 0 ft. to 20 ft. From 20 ft. to 23 ft. From ft. to ft. What is the nearest source of possible contamination: 1 Septic tank 2 Sewer lines 3 Watertight sewer lines 4 Lateral lines 5 Cess pool 6 Seepage pit 7 Pit privy 8 Sewage lagoon 9 Feedyard 10 Livestock pens 11 Fuel storage 12 Fertilizer storage 13 Insecticide storage 14 Abandoned water well 15 Oil well/Gas well 16 Other (specify below) Former. UST. Basin. Direction from well? NW How many feet? 540.

Table with columns: FROM, TO, LITHOLOGIC LOG, FROM, TO, PLUGGING INTERVALS. Rows include: 0 to 0.5 Topsoil/Vegetation, 0.5 to 18 Clay, Brown, 18 to 30 Sand, 30 to 40 Sand.

7 CONTRACTOR'S OR LANDOWNER'S CERTIFICATION: This water well was (1) constructed, (2) reconstructed, or (3) plugged under my jurisdiction and was completed on (mo/day/year) 7/31/96 and this record is true to the best of my knowledge and belief. Kansas Water Well Contractor's License No. 527. This Water Well Record was completed on (mo/day/yr) 8/3/96 under the business name of GeoCore Services, Inc. by (signature) Bob Bell.

OFFICE USE ONLY T R EW SEC 1/4 1/4 1/4