


1	LOCATION OF WATER WELL:	Fraction	Section Number	Township Number	Range Number
County:	Ness	NE 1/4 NW 1/4 SW 1/4	31	T 18 S	R 21

Distance and direction from nearest town or city street address of well if located within city?

South of the Baine Coop, Baizne, Kansas

2	WATER WELL OWNER:	Board of Agriculture, Division of Water Resources	
RR#, St. Address, Box # :	KDHE	Application Number:	
City, State, ZIP Code :	Forbes Field, Bldg 740 Topeka, Kansas		

3 LOCATE WELL'S LOCATION WITH AN "X" IN SECTION BOX:

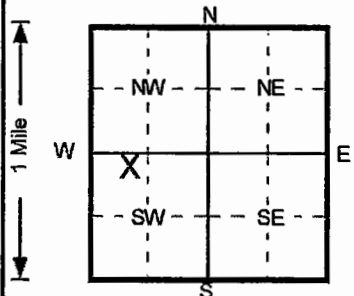

4 DEPTH OF COMPLETED WELL **38** ft. ELEVATION: **2128.56** ft.

Depth(s) Groundwater Encountered 1. ft. 2. ft. 3. ft.

WELL'S STATIC WATER LEVEL **27.8** ft. below land surface measured on mo/day/yr **7/25/98**

Pump test data: Well water was **NA** ft. after hours pumping gpm

Est. Yield **NA** gpm: Well water was ft. after hours pumping gpm

Bore Hole Diameter **8** in. to **38** ft., and in. to ft.

WELL WATER TO BE USED AS: 5 Public water supply 8 Air conditioning 11 Injection well

1 Domestic 3 Feedlot 6 Oil field water supply 9 Dewatering 12 Other (Specify below)

2 Irrigation 4 Industrial 7 Lawn and garden only 10 **Monitoring well**

Was a chemical/bacteriological sample submitted to Department? Yes.....No.....; If yes, mo/day/yr sample was submitted Water Well Disinfected? Yes No

5 TYPE OF BLANK CASING USED:

1 Steel	3 RMP (SR)	5 Wrought iron	8 Concrete tile	CASING JOINTS: Glued Clamped
2 PVC	4 ABS	6 Asbestos-Cement	9 Other (specify below)	Welded
		7 Fiberglass		Threaded. <input checked="" type="checkbox"/>

Blank casing diameter **2** in. to **26.6** ft., Dia in. to ft., Dia in. to ft.

Casing height above land surface **-3.84** in., weight **Sch 40** lbs./ft. Wall thickness or gauge No.

TYPE OF SCREEN OR PERFORATION MATERIAL

1 Steel	3 Stainless steel	5 Fiberglass	8 RMP (SR)	10 Asbestos-cement
2 Brass	4 Galvanized steel	6 Concrete tile	9 ABS	11 Other (specify)
				12 None used (open hole)

SCREEN OR PERFORATION OPENINGS ARE:

1 Continuous slot	3 Mill slot	5 Gauzed wrapped	8 Saw cut	11 None (open hole)
2 Louvered shutter	4 Key punched	6 Wire wrapped	9 Drilled holes	
		7 Torch cut	10 Other (specify)	

SCREEN-PERFORATED INTERVALS: From **21** ft. to **38** ft., From ft. to ft.

GRAVEL PACK INTERVALS: From **21** ft. to **38** ft., From ft. to ft.

6 GROUT MATERIAL: 1 Neat cement 2 **Cement grout** 3 **Bentonite** 4 Other

Grout Intervals: From **0** ft. to **3** ft., From **3** ft. to **16.6** ft., From **16.6** ft. to **21** ft.

What is the nearest source of possible contamination:

1 Septic tank	4 Lateral lines	7 Pit privy	10 Livestock pens	14 Abandoned water well
2 Sewer lines	5 Cess pool	8 Sewage lagoon	11 Fuel storage	15 Oil well/Gas well
3 Watertight sewer lines	6 Seepage pit	9 Feedyard	12 Fertilizer storage	16 Other (specify below)

Direction from well? How many feet? **Unknown**

FROM	TO	LITHOLOGIC LOG	FROM	TO	PLUGGING INTERVALS
0	0.5	Grass Thatch,			
0.5	10	Clayey Silt/Silty Clay, Dark Yellowish Brown			
10	15	Silt, Yellowish Brown			
15	20	Clayey Silt, Dark Yellowish Brown			
20	22	Silt, Olive Yellow			
22	26	Fine Sand, Yellowish Brown			
26	38	Medium Sand, Yellowish Brown			
					MW15, Tag #, Flushmount
					Project Name: BM - Bazine
					GeoCore # 693, #

7 CONTRACTOR'S OR LANDOWNER'S CERTIFICATION: This water well was (1) constructed, (2) reconstructed, or (3) plugged under my jurisdiction and was completed on (mo/day/year) **7/25/98** and this record is true to the best of my knowledge and belief.

Kansas Water Well Contractor's License No. **527** This Water Well Record was completed on (mo/day/yr) **8/23/98**

under the business name of **GeoCore Services, Inc.** by (signature) **Dale Roll**

OFFICE USE ONLY
T
R
EMW
SEC
1/4
1/4
1/4