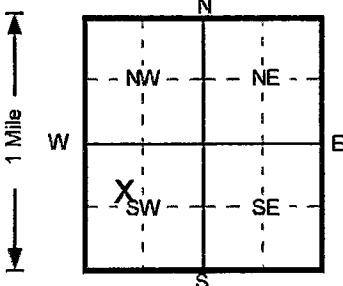


1 LOCATION OF WATER WELL: County: Ness	Fraction SE ¼ NW ¼ SW ¼	Section Number 31	Township Number T 18 S	Range Number R 21 E/W
--	-----------------------------------	-----------------------------	----------------------------------	---------------------------------

Distance and direction from nearest town or city street address of well if located within city?

1/2 Blk E. off of Lawrence St. on Ave. A, Bazine

2 WATER WELL OWNER: **KDHE**
 RR#, St. Address, Box # : **Forbes Field, Bldg 740**
 City, State, ZIP Code : **Topeka, Kansas**
 Board of Agriculture, Division of Water Resources
 Application Number:

3 LOCATE WELL'S LOCATION WITH AN "X" IN SECTION BOX: 	4 DEPTH OF COMPLETED WELL 36.6 ft. ELEVATION: 2128.53 Depth(s) Groundwater Encountered 1. ft. 2. ft. 3. ft. WELL'S STATIC WATER LEVEL 26 ft. below land surface measured on mo/day/yr 7/24/98 Pump test data: Well water was NA ft. after hours pumping gpm Est. Yield NA gpm: Well water was ft. after hours pumping gpm Bore Hole Diameter 8 in. to 38 ft., and in. to ft. WELL WATER TO BE USED AS: 5 Public water supply 8 Air conditioning 11 Injection well 1 Domestic 3 Feedlot 6 Oil field water supply 9 Dewatering 12 Other (Specify below) 2 Irrigation 4 Industrial 7 Lawn and garden only 10 Monitoring well Was a chemical/bacteriological sample submitted to Department? Yes.....No.....; If yes, mo/day/yr sample was submitted Water Well Disinfected? Yes No <input checked="" type="checkbox"/>
--	---

5 TYPE OF BLANK CASING USED:
 1 Steel 3 RMP (SR) 5 Wrought iron 8 Concrete tile CASING JOINTS: Glued Clamped
 2 PVC 4 ABS 6 Asbestos-Cement 9 Other (specify below) Welded
 7 Fiberglass Threaded.
 Blank casing diameter **2** in. to **26.6** ft., Dia in. to ft., Dia in. to ft.
 Casing height above land surface **2.88** in., weight **Sch 40** lbs./ft. Wall thickness or gauge No.
 TYPE OF SCREEN OR PERFORATION MATERIAL
 1 Steel 3 Stainless steel 5 Fiberglass 7 PVC 10 Asbestos-cement
 2 Brass 4 Galvanized steel 6 Concrete tile 8 RMP (SR) 11 Other (specify)
 12 None used (open hole)
 SCREEN OR PERFORATION OPENINGS ARE:
 1 Continuous slot 3 Mill slot 5 Gauzed wrapped 8 Saw cut 11 None (open hole)
 2 Louvered shutter 4 Key punched 6 Wire wrapped 9 Drilled holes
 7 Torch cut 10 Other (specify)
 SCREEN-PERFORATED INTERVALS: From **26.6** ft. to **36.6** ft., From ft. to ft.
 From ft. to ft., From ft. to ft.
 GRAVEL PACK INTERVALS: From **21** ft. to **38** ft., From ft. to ft.
 From ft. to ft., From ft. to ft.

6 GROUT MATERIAL: 1 Neat cement 2 Cement grout 3 Bentonite 4 Other
 Grout Intervals: From **0** ft. to **3** ft., From **3** ft. to **16** ft., From ft. to ft.
 What is the nearest source of possible contamination:
 1 Septic tank 4 Lateral lines 7 Pit privy 10 Livestock pens 14 Abandoned water well
 2 Sewer lines 5 Cess pool 8 Sewage lagoon 11 Fuel storage 15 Oil well/Gas well
 3 Watertight sewer lines 6 Seepage pit 9 Feedyard 12 Fertilizer storage **16** Other (specify below)
 13 Insecticide storage
 Direction from well?
 How many feet?

FROM	TO	LITHOLOGIC LOG	FROM	TO	PLUGGING INTERVALS
0	0.5	Grass Thatch,			
0.5	5	Clayey Silt, Brown			
5	10	Silt, Light Yellowish Brown			
10	11	Clayey Silt, Yellowish Brown			
11	20	Silt, Light Yellowish Brown			
20	23	Clayey Silt, Yellowish Brown			
23	25	Silty Clay, Yellowish Brown			
25	30	Silty Clay, Light Yellowish Brown			
30	35	Silty Clay/Clayey Silt, Dark Red Black			
35	38	Sand, Pale Yellow			
					MW13, Tag #, Flushmount
					Project Name: BM - Bazine
					GeoCore # 693, #

7 CONTRACTOR'S OR LANDOWNER'S CERTIFICATION: This water well was **(1)** constructed, (2) reconstructed, or (3) plugged under my jurisdiction and was completed on (mo/day/year) **7/23/98** and this record is true to the best of my knowledge and belief.
 Kansas Water Well Contractor's License No. **527** This Water Well Record was completed on (mo/day/yr) **8/23/98**
 under the business name of **GeoCore Services, Inc.** by (signature) *Josh Kelly*

OFFICE USE ONLY
T
R
EW
SEC.
1/4
1/4
1/4