


1 LOCATION OF WATER WELL: Fraction SW 1/4 SW 1/4 NE 1/4 Section Number 33 Township Number T 18 S Range Number R 21W EW

Distance and direction from nearest town or city street address of well if located within city? 3 E of Bazine, Kansas

2 WATER WELL OWNER: Verlin Whitton RR#, St. Address, Box #: Bazine, Kansas City, State, ZIP Code: 67516 Board of Agriculture, Division of Water Resources Application Number:

3 LOCATE WELL'S LOCATION WITH AN "X" IN SECTION BOX:

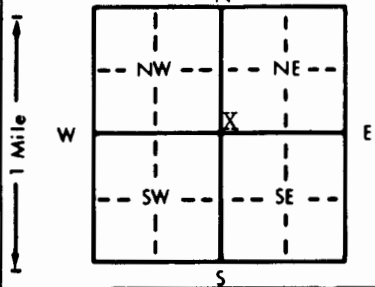

4 DEPTH OF COMPLETED WELL: 280 ft. ELEVATION: Unknown. Depth(s) Groundwater Encountered: 1.150 ft. WELL'S STATIC WATER LEVEL: 150 ft. below land surface measured on 11/20/91. Pump test data: Well water was ... ft. after ... hours pumping ... gpm. Est. Yield: 60 gpm. Bore Hole Diameter: .8 in. to .280 ft. WELL WATER TO BE USED AS: 5 Public water supply, 8 Air conditioning, 11 Injection well, 1 Domestic, 3 Feedlot, 6 Oil field water supply, 9 Dewatering, 12 Other (Specify below), 2 Irrigation, 4 Industrial, 7 Lawn and garden only, 10 Monitoring well. Was a chemical/bacteriological sample submitted to Department? Yes No; If yes, mo/day/yr sample was submitted. Water Well Disinfected? Yes No

5 TYPE OF BLANK CASING USED: 1 Steel, 3 RMP (SR), 2 PVC, 4 ABS, 5 Wrought iron, 8 Concrete tile, 6 Asbestos-Cement, 9 Other (specify below), 7 Fiberglass. CASING JOINTS: Glued, Clamped, Welded, Threaded. Blank casing diameter: 5 in. to 260 ft. Dia. Casing height above land surface: 12 in., weight: 2.8 lbs./ft. Wall thickness or gauge No. Sch. 40.

TYPE OF SCREEN OR PERFORATION MATERIAL: 1 Steel, 3 Stainless steel, 5 Fiberglass, 8 RMP (SR), 2 Brass, 4 Galvanized steel, 6 Concrete tile, 9 ABS, 7 PVC, 10 Asbestos-cement, 11 Other (specify), 12 None used (open hole).

SCREEN OR PERFORATION OPENINGS ARE: 1 Continuous slot, 3 Mill slot, 5 Gauzed wrapped, 8 Saw cut, 2 Louvered shutter, 4 Key punched, 6 Wire wrapped, 9 Drilled holes, 7 Torch cut, 10 Other (specify), 11 None (open hole).

SCREEN-PERFORATED INTERVALS: From 260 ft. to 280 ft. GRAVEL PACK INTERVALS: From 20 ft. to 280 ft.

6 GROUT MATERIAL: 1 Neat cement, 2 Cement grout, 3 Bentonite, 4 Other. Grout intervals: From 0 ft. to 20 ft.

What is the nearest source of possible contamination: 1 Septic tank, 4 Lateral lines, 7 Pit privy, 10 Livestock pens, 14 Abandoned water well, 2 Sewer lines, 5 Cess pool, 8 Sewage lagoon, 11 Fuel storage, 15 Oil well/Gas well, 3 Watertight sewer lines, 6 Seepage pit, 9 Feedyard, 12 Fertilizer storage, 16 Other (specify below), 13 Insecticide storage, In. pasture.

Direction from well? How many feet?

Table with columns: FROM, TO, LITHOLOGIC LOG, FROM, TO, PLUGGING INTERVALS. Row 1: 0 to 50, Clay and limestone. Row 2: 50 to 250, Shale. Row 3: 250 to 280, Sand rock.

7 CONTRACTOR'S OR LANDOWNER'S CERTIFICATION: This water well was (1) constructed, (2) reconstructed, or (3) plugged under my jurisdiction and was completed on (mo/day/year) 11/20/91 and this record is true to the best of my knowledge and belief. Kansas Water Well Contractor's License No. 186. This Water Well Record was completed on (mo/day/yr) 12/30/91 under the business name of Kelly's Water Well Service by (signature) [Signature]

INSTRUCTIONS: Use typewriter or ball point pen. PLEASE PRESS FIRMLY and PRINT clearly. Please fill in blanks, underline or circle the correct answers. Send top three copies to Kansas Department of Health and Environment, Bureau of Water, Topeka, Kansas 66620-0001. Telephone: 913-296-5545. Send one to WATER WELL OWNER and retain one for your records.